HERITAGE REALTY, INC.

Lot 4, Bl. 2, Kingston Heights Subdivision
Sec. 25, T.10 S., R.4 W., W.M.
Benton County, Oregon

Scale: 1" = 30'

November 3, 1971
Orris A. Carnegie
Registered Oregon Land Surveyor
By: Walter Strandt

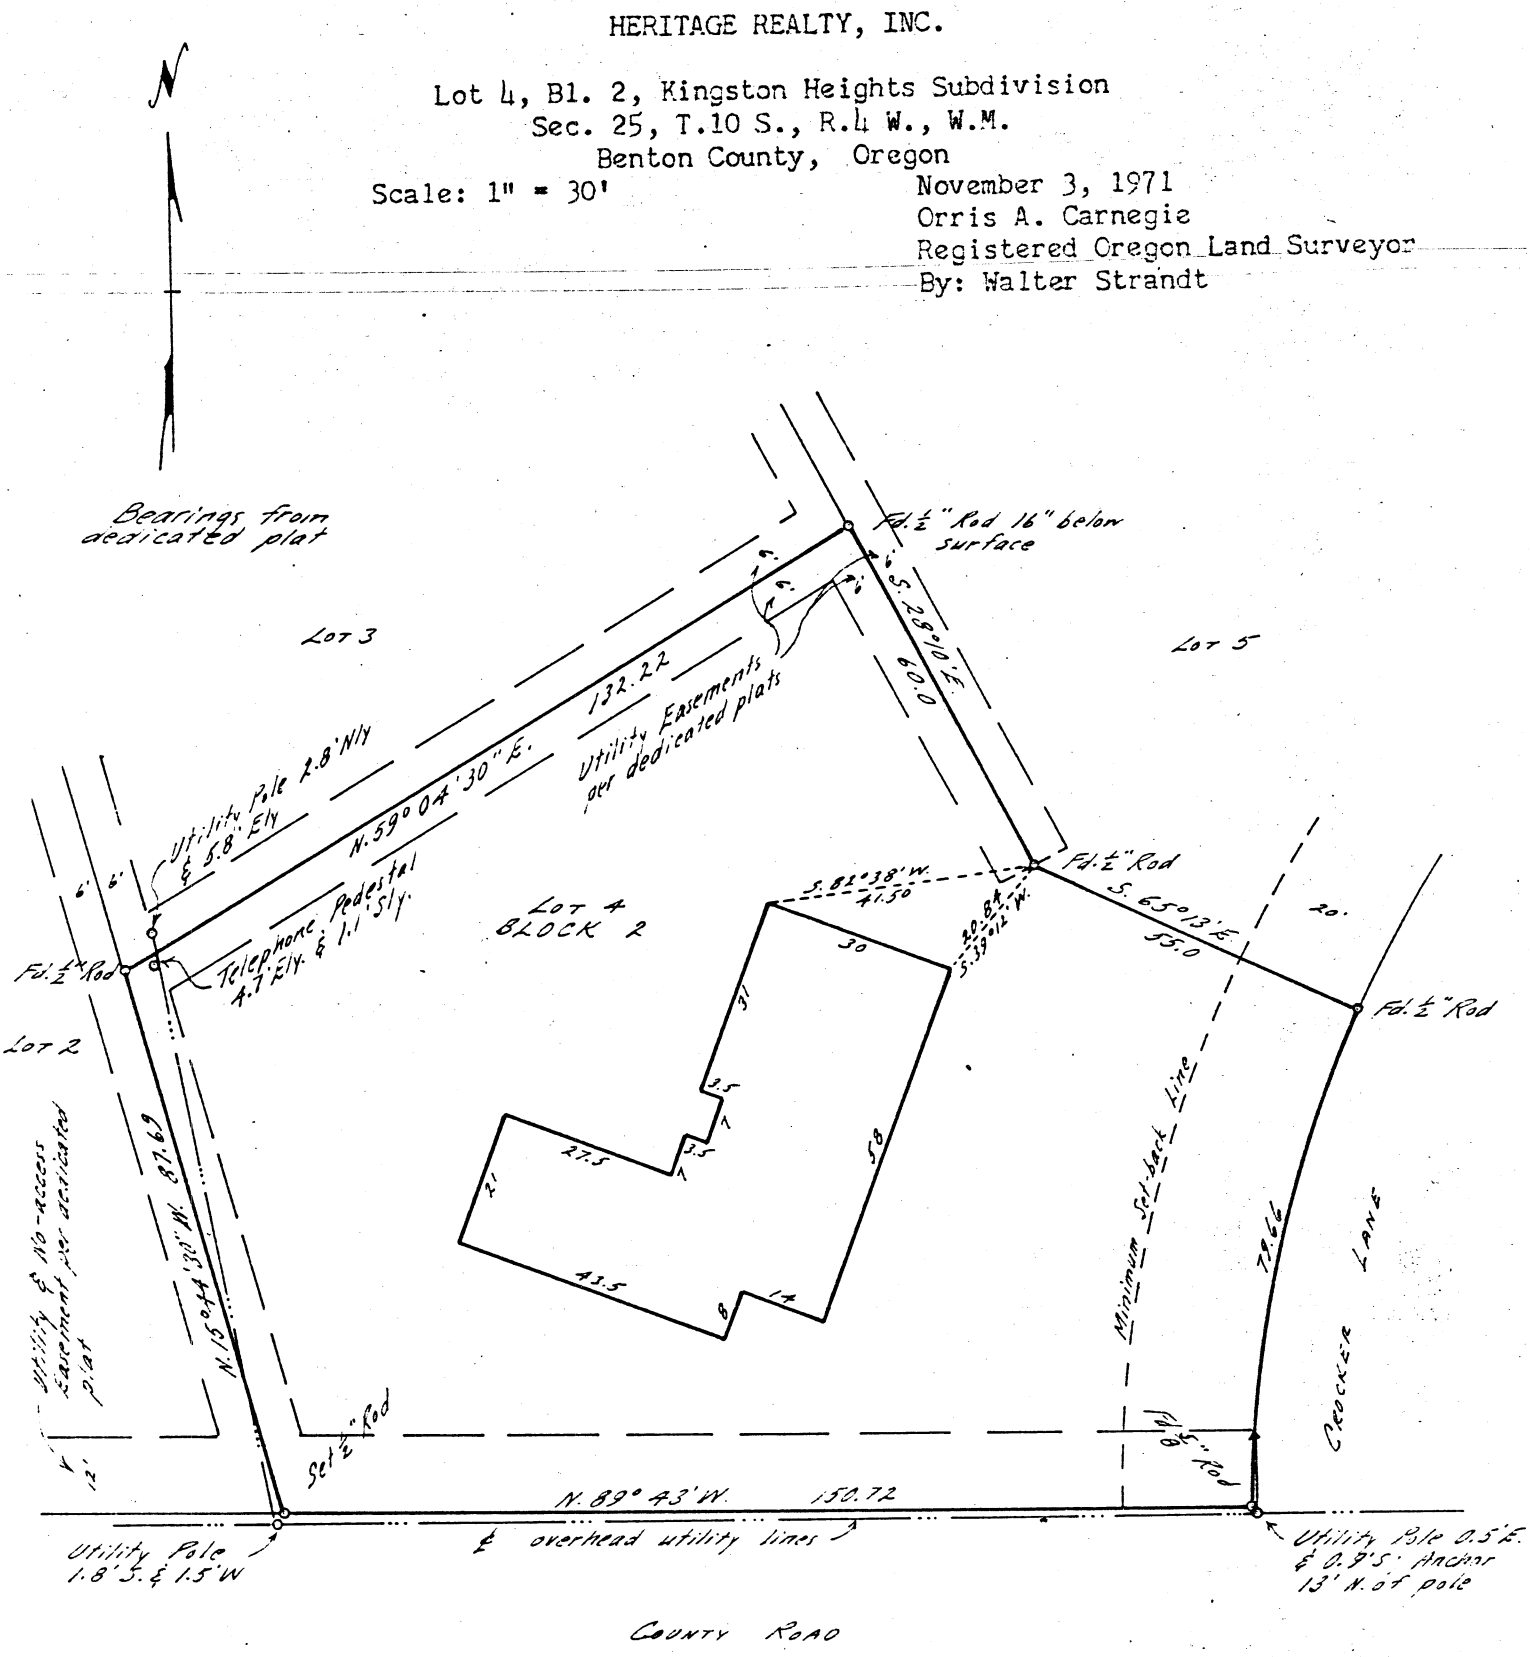

Description: Lot 4, Block 2, KINGSTON HEIGHTS SUBDIVISION, Benton County, Oregon.

Certificate: I certify that the herein described property was surveyed under my immediate supervision and that the improvements shown were found to be on the premises in question and that they do not overlap or encroach on the property adjacent thereto.

REGISTERED
OREGON
LAND SURVEYOR
Orris A. Carnegie
MAY 9, 1947
ORRIS A. CARNEGIE
213

Benton County
Surveyor's Office
C. S. FILE NO. 7904
FILING DATE 7-21-86
SIZE 8½X14

THIS [illegible] RECEIVED OCT. 1987
[illegible] SURVEYOR'S OFFICE