CS 7978 3-20-87

LOT LINE ADJUSTMENT
for
JOHN SALSMA
in the
Sorah Adkins D.L.C. No. 45
in the
S.E. 1/4 of Section 30, T. 10S., R. 3 W., W.B.&M.
Benton County, Oregon
Scale: 1" = 400 March 6, 1987

Narrative: The purpose of this survey was to establish a line and prepare deeds agreeable to both parties, Salsma and Clem.

MOORE SURVEYING
424 SECOND AVE., S.E.
ALBANY, OREGON 97321

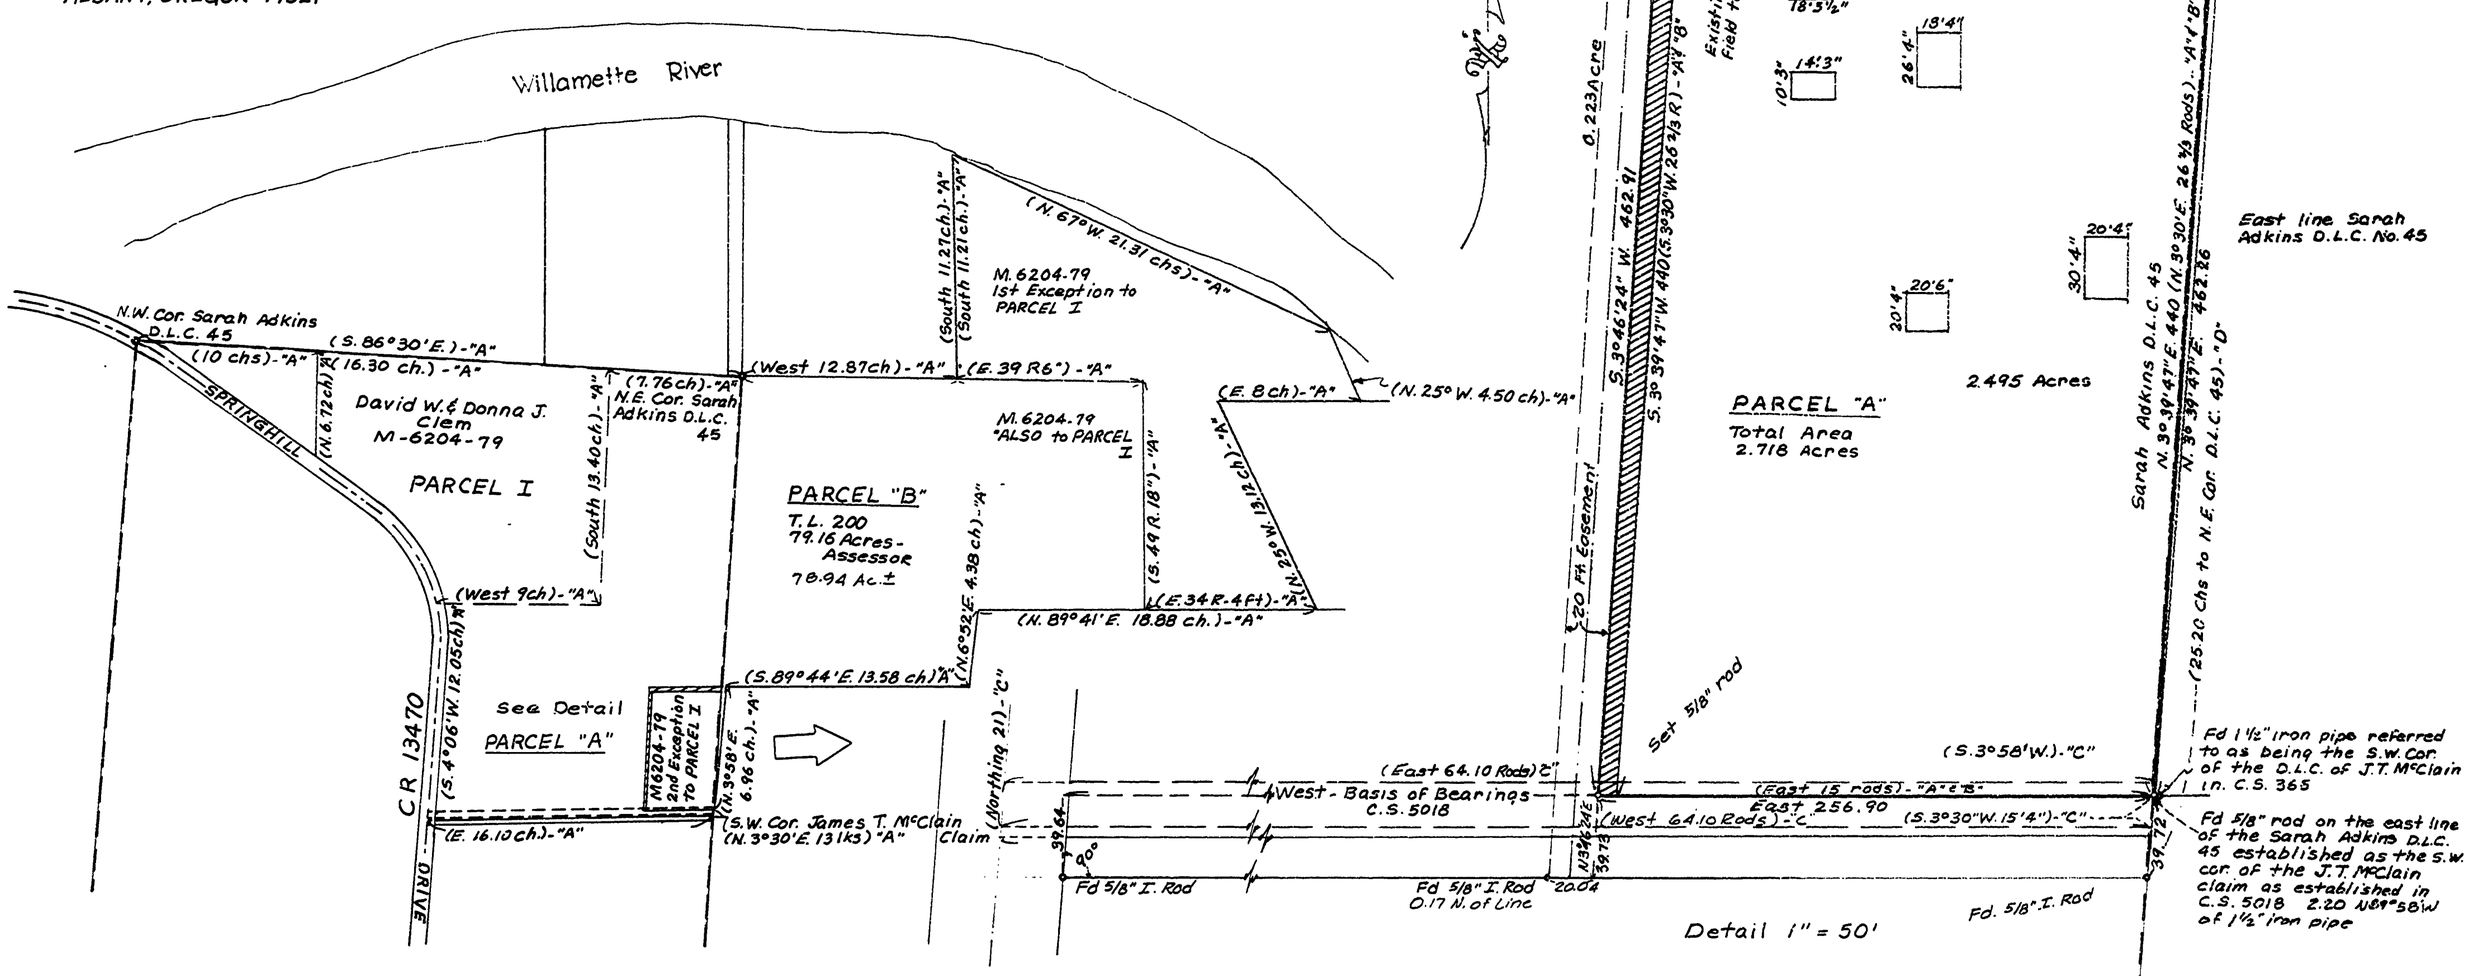

Note: ( )-A indicates information from Benton County Deed Records M. 6204-79
B " " " " " " " Book 105, Pg 59 (b)
C " " " " " " " " 86, " 485
D " " " " " " " M. 53049-83

ALL Rods set were 5/8" x 30" rebar with yellow plastic caps marked L.S. 501

APPROVAL: This Lot Line Adjustment approved this ___ day of March, 1987

Benton County Planning Director

REGISTERED PROFESSIONAL LAND SURVEYOR
Verle O. Moore
OREGON MAY 19, 1967
VERLE O. MOORE
501

Benton County Surveyor's Office
C.S. FILE NO. 7978
FILING DATE 3/20/1987
FILE SIZE 18"x24"
AF

NOTE: IF THIS MICROFILMED DRAWING IS LESS CLEAR THAN THIS NOTICE, IT IS DUE TO