8090

8090

CS 8090
12/30/87

RECORD OF SURVEY

for GLEN RUNYON

in S ½ Section 15, NW ¼ Section 22,

SE ¼ Section 16,

James Greer D.L.C. No. 50,

Samuel Rice D.L.C. No. 45, T.10S., R.6W., W.M.

Benton County, Oregon

December 22, 1987

Benton County
Surveyor's Office
C. S. FILE NO. 8090
FILING DATE 12/30/87
FILE SIZE 18" x 24"

LEGEND

- ● FOUND MONUMENT AS NOTED
- o SET 5/8" X 30" IRON ROD WITH YELLOW PLASTIC CAP MARKED "LS 1102"
- ( ) RECORD DATA FROM COUNTY ROAD No. 06580 MAP
- [ ] RECORD DATA FROM HARDCOPY 10-6-00017
- **** EXISTING FENCE

N

SCALE: 1" = 200'

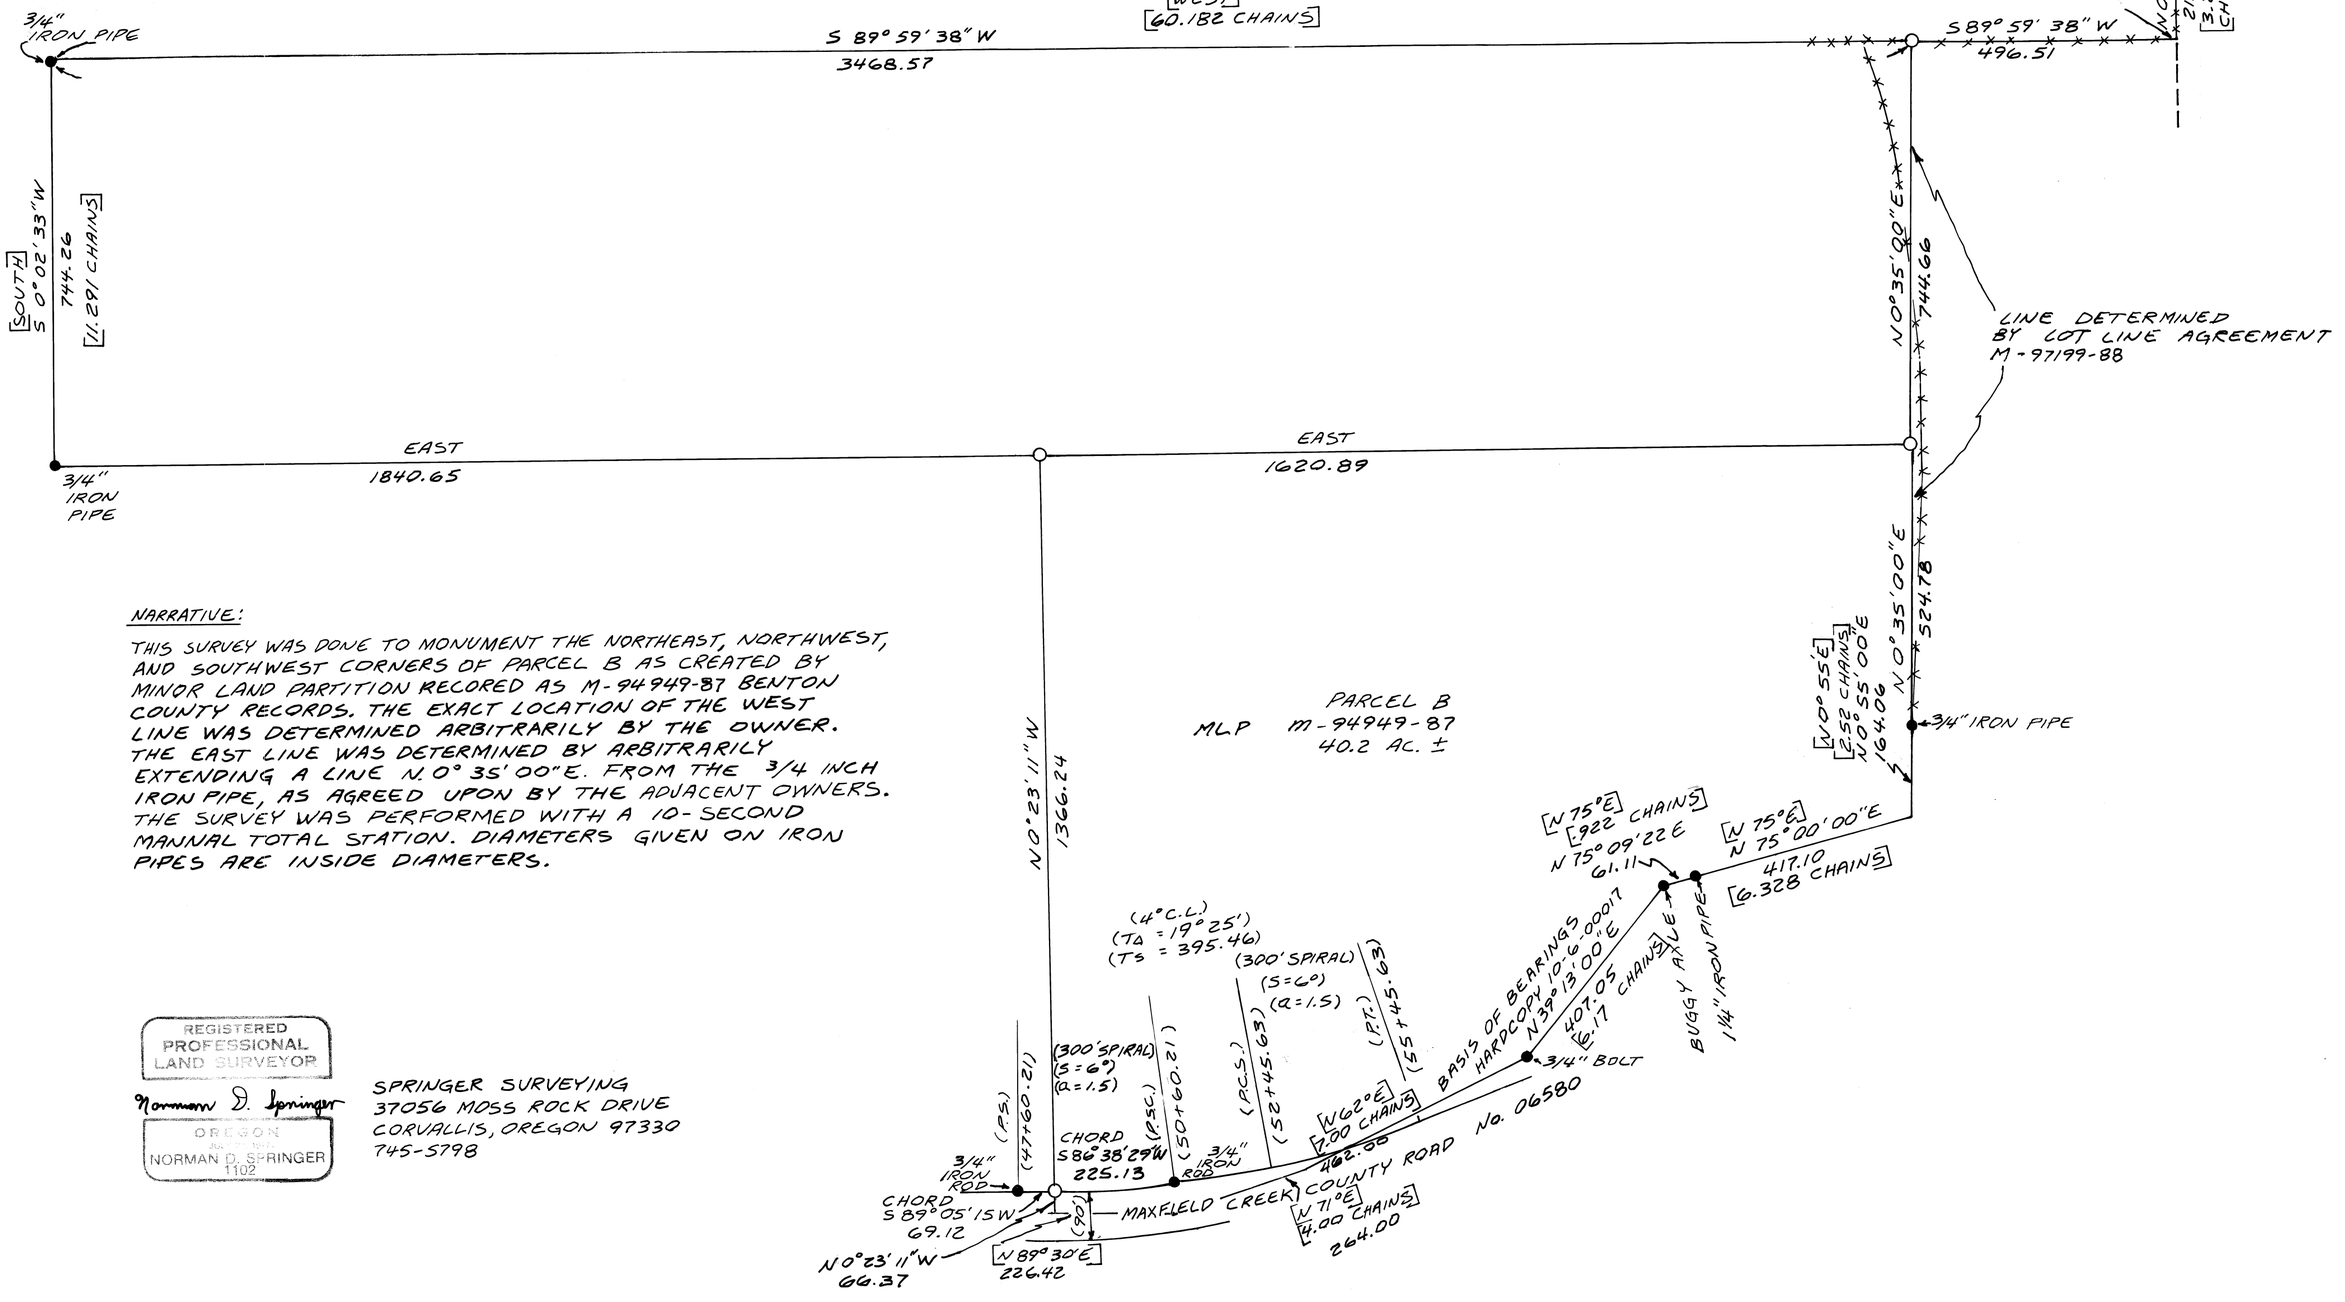

NARRATIVE:

THIS SURVEY WAS DONE TO MONUMENT THE NORTHEAST, NORTHWEST, AND SOUTHWEST CORNERS OF PARCEL B AS CREATED BY MINOR LAND PARTITION RECORED AS M-94949-87 BENTON COUNTY RECORDS. THE EXACT LOCATION OF THE WEST LINE WAS DETERMINED ARBITRARILY BY THE OWNER. THE EAST LINE WAS DETERMINED BY ARBITRARILY EXTENDING A LINE N. 0° 35' 00" E. FROM THE 3/4 INCH IRON PIPE, AS AGREED UPON BY THE ADJACENT OWNERS. THE SURVEY WAS PERFORMED WITH A 10-SECOND MANNAL TOTAL STATION. DIAMETERS GIVEN ON IRON PIPES ARE INSIDE DIAMETERS.

REGISTERED PROFESSIONAL LAND SURVEYOR
Norman D. Springer
OREGON
JULY 10, 1981
NORMAN D. SPRINGER
1102

SPRINGER SURVEYING
37056 MOSS ROCK DRIVE
CORVALLIS, OREGON 97330
745-5798