DRAWING NUMBER
8100

PLAN HOLD CORPORATION • IRVINE, CALIFORNIA
REORDER BY NUMBER 075AR

DRAWING NUMBER
8100

PLAN HOLD CORPORATION • IRVINE, CALIFORNIA
REORDER BY NUMBER 075AR

AWING NUMBER
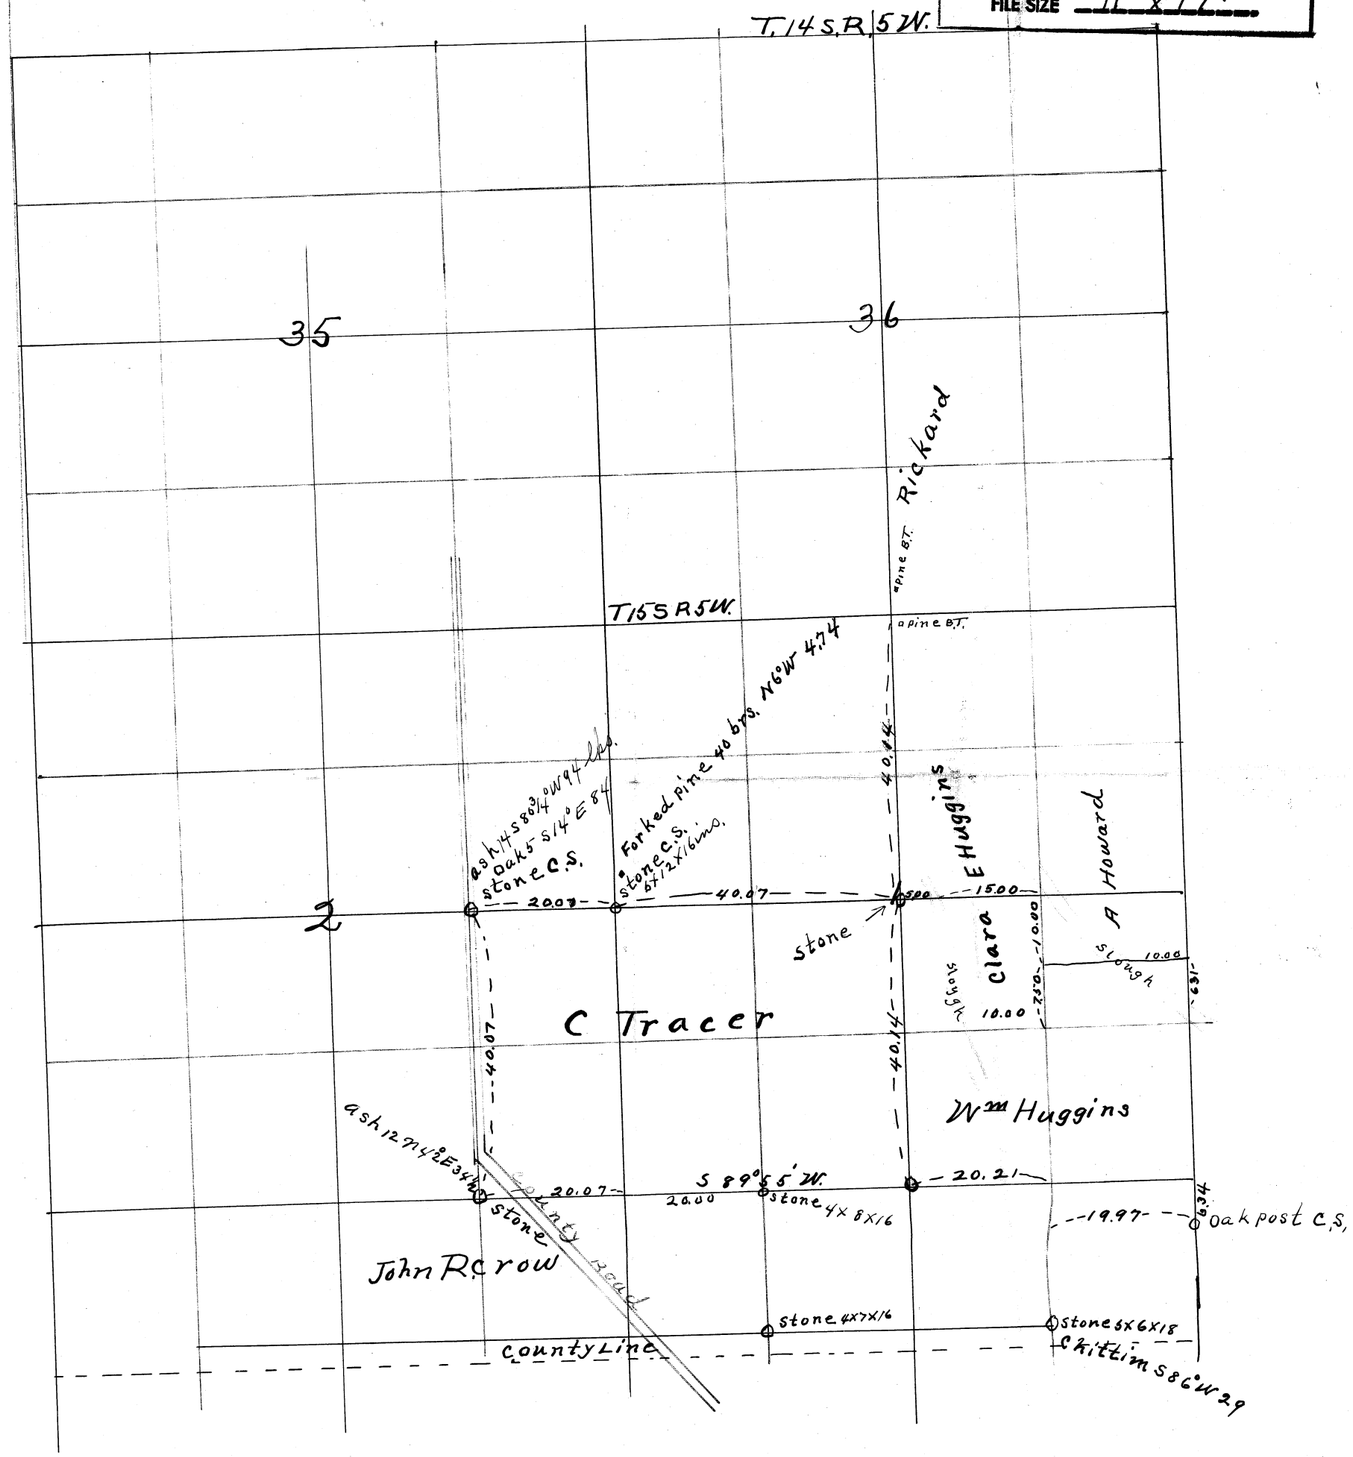
Benton Co. Surveyors Office
C. S. FILE NO. 8100
FILING DATE 1-29-88
FILE SIZE 11" x 17"