DRAWING NUMBER 8338

PLAN HOLD CORPORATION • IRVINE, CALIFORNIA

REORDER BY NUMBER 075AR

POSITION EDGE OF PRINT ON THIS LINE

DRAWING NUMBER 8338

PLAN HOLD CORPORATION • IRVINE, CALIFORNIA

REORDER BY NUMBER 075AR

POSITION EDGE OF PRINT ON THIS LINE

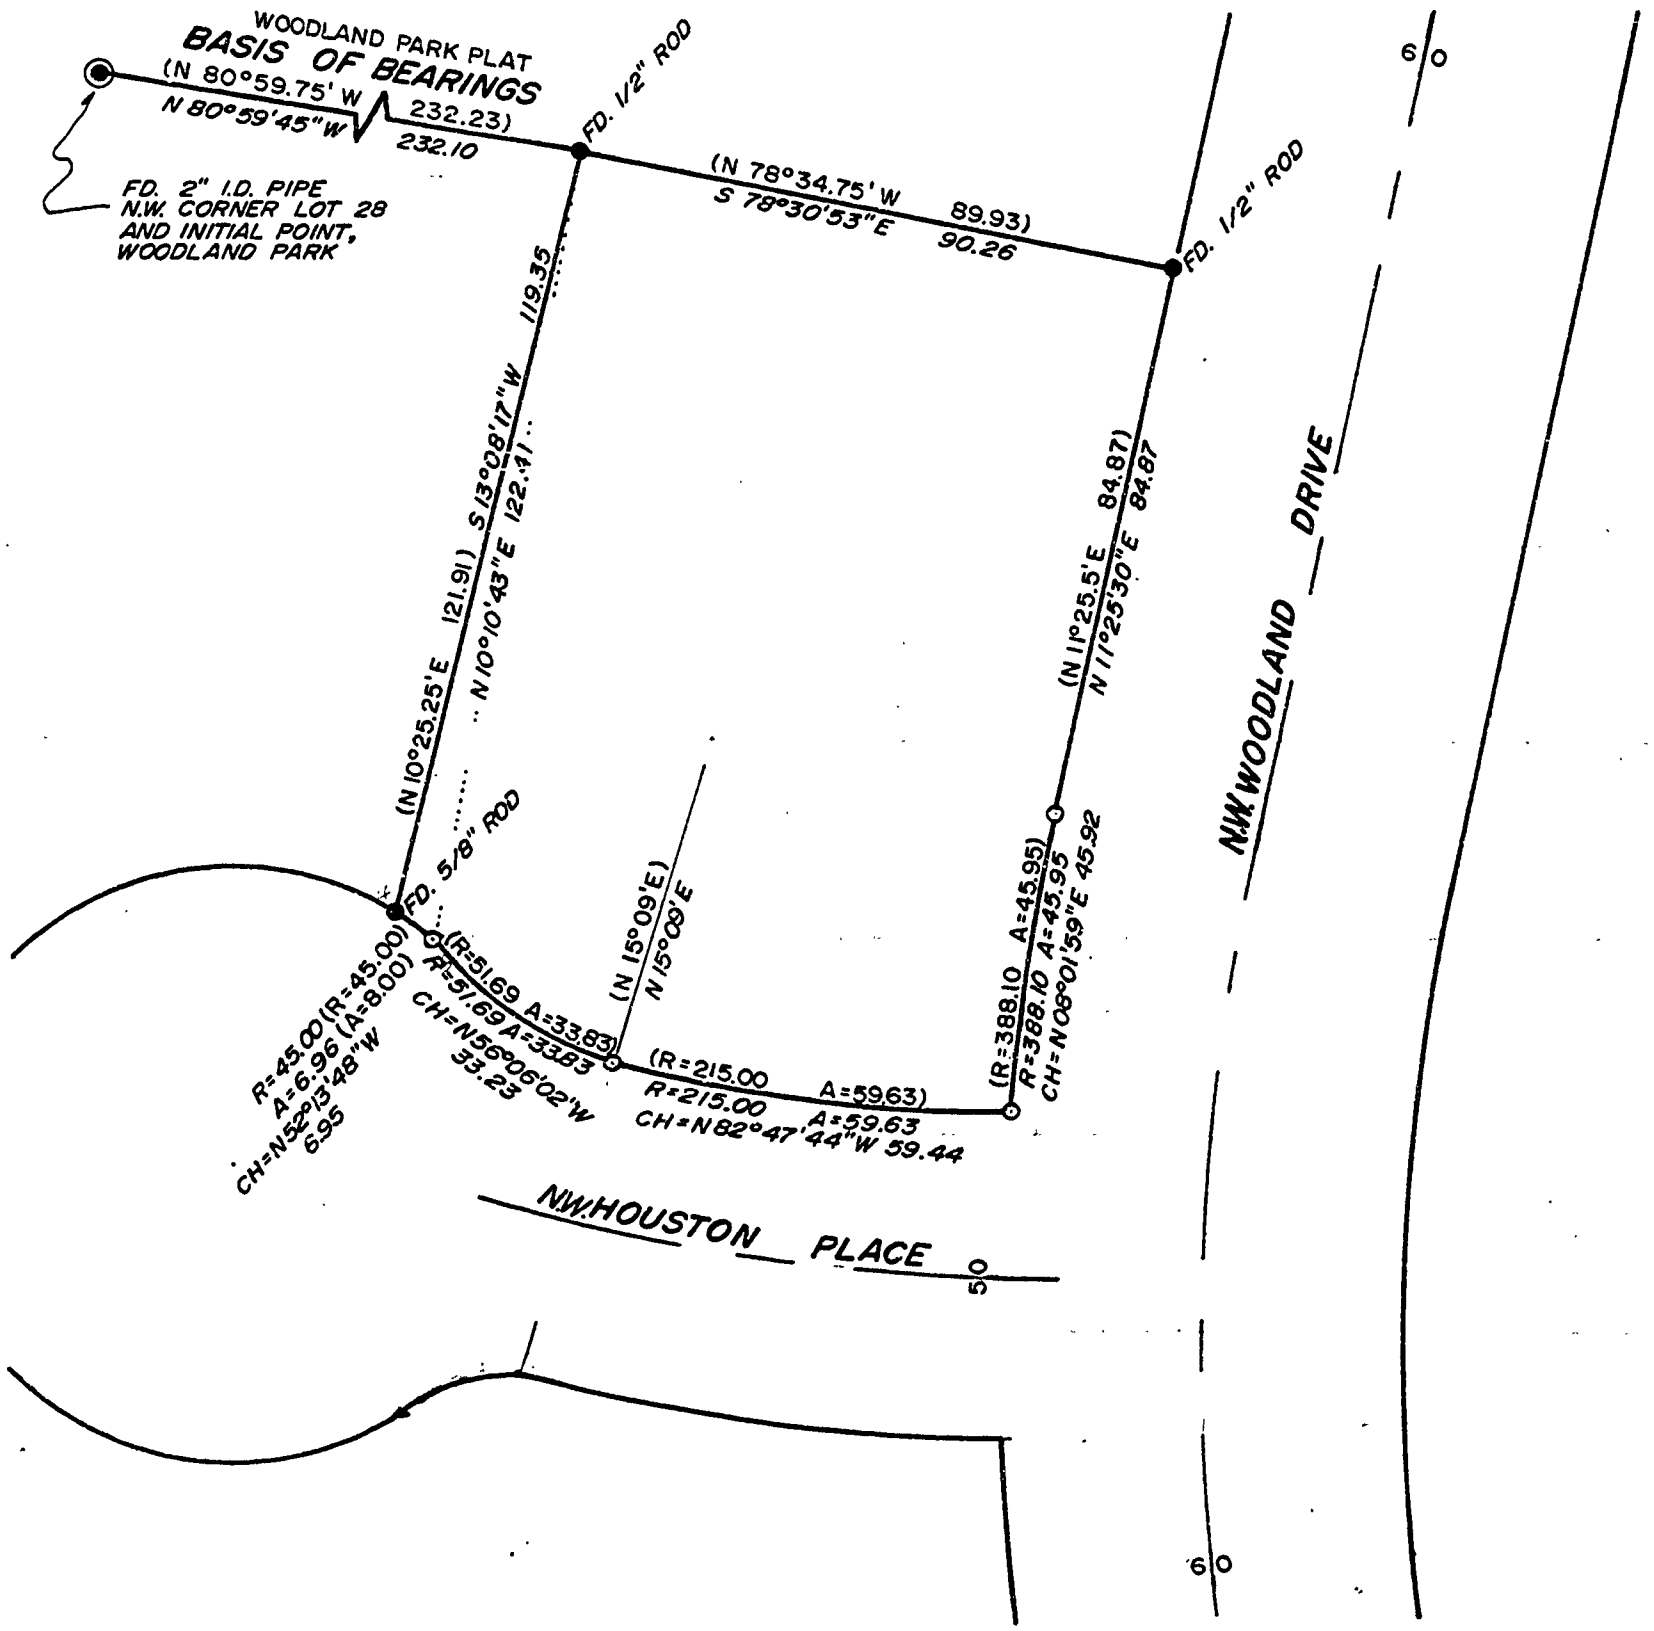

MAP OF
SURVEY for:

CHUCK BLAKLEY

SEPT. 20, 1989 SCALE: 1" = 30'

N.E. 1/4 SECTION 28 , JOHN D. MULKEY D.L.C. 54
T. 11S., R. 5 W., W.M., BENTON COUNTY, OREGON

LOT 30, BLOCK 5
WOODLAND PARK
BENTON COUNTY, OR.

LEGEND

- ● MONUMENT FOUND, TYPE NOTED
- O SET 5/8" X 30" IRON ROD WITH YELLOW PLASTIC CAP STAMPED "DW HARMS LS 1079"
- ( ) INFORMATION FROM WOODLAND PARK PLAT

NARRATIVE

THE PURPOSE OF THIS SURVEY IS TO VERIFY EXISTING AND REPLACE MISSING CORNERS MONUMENTS OF LOT 30, BLOCK 5, WOODLAND PARK. I HELD FOUND MONUMENTS IN POSITION AND RECORD PLAT DATA TO REPLACE MISSING MONUMENTS. THE RECORD DATA FOR THE WEST LINE (N 10° 25.25'E 121.91) APPEAPS TO HAVE BEEN THE BEARING AND DISTANCE FROM THE N.W. CORNER TO THE P.R.C. ON HOUSTON PLACE.

DARRYL W. HARMS, P.L.S.
P.O. BOX 1051
CORVALLIS, OR. 97339
PHONE: (503) 758-5579

REGISTERED
PROFESSIONAL
LAND SURVEYOR

Darryl W. Harms

OREGON
JULY 30, 1976
DARRYL W. HARMS
1079

Benton County
Surveyor's Office

C.S. FILE NO. 8338
FILING DATE 10-28-89
FILE SIZE 11X17