IBER
INE, CALIFORNIA
DRAWING NUMBER 8673
PLAN HOLD CORPORATION • IRVINE, CALIFORNIA
REORDER BY NUMBER 075AR
DRAWING NUMBER
PLAN HOLD CORPORATION • IRVINE, CALIFORNIA
REORDER BY NUMBER 075AR
DRAWING NUMBER 8673
PLAN HOLD CORPORATION • IRVINE, CA
REORDER BY NUMBER 075AR

Benton County
Surveyor's Office
C.S. FILE NO. 8673
FILING DATE 1-22-1993
FILE SIZE 18x20

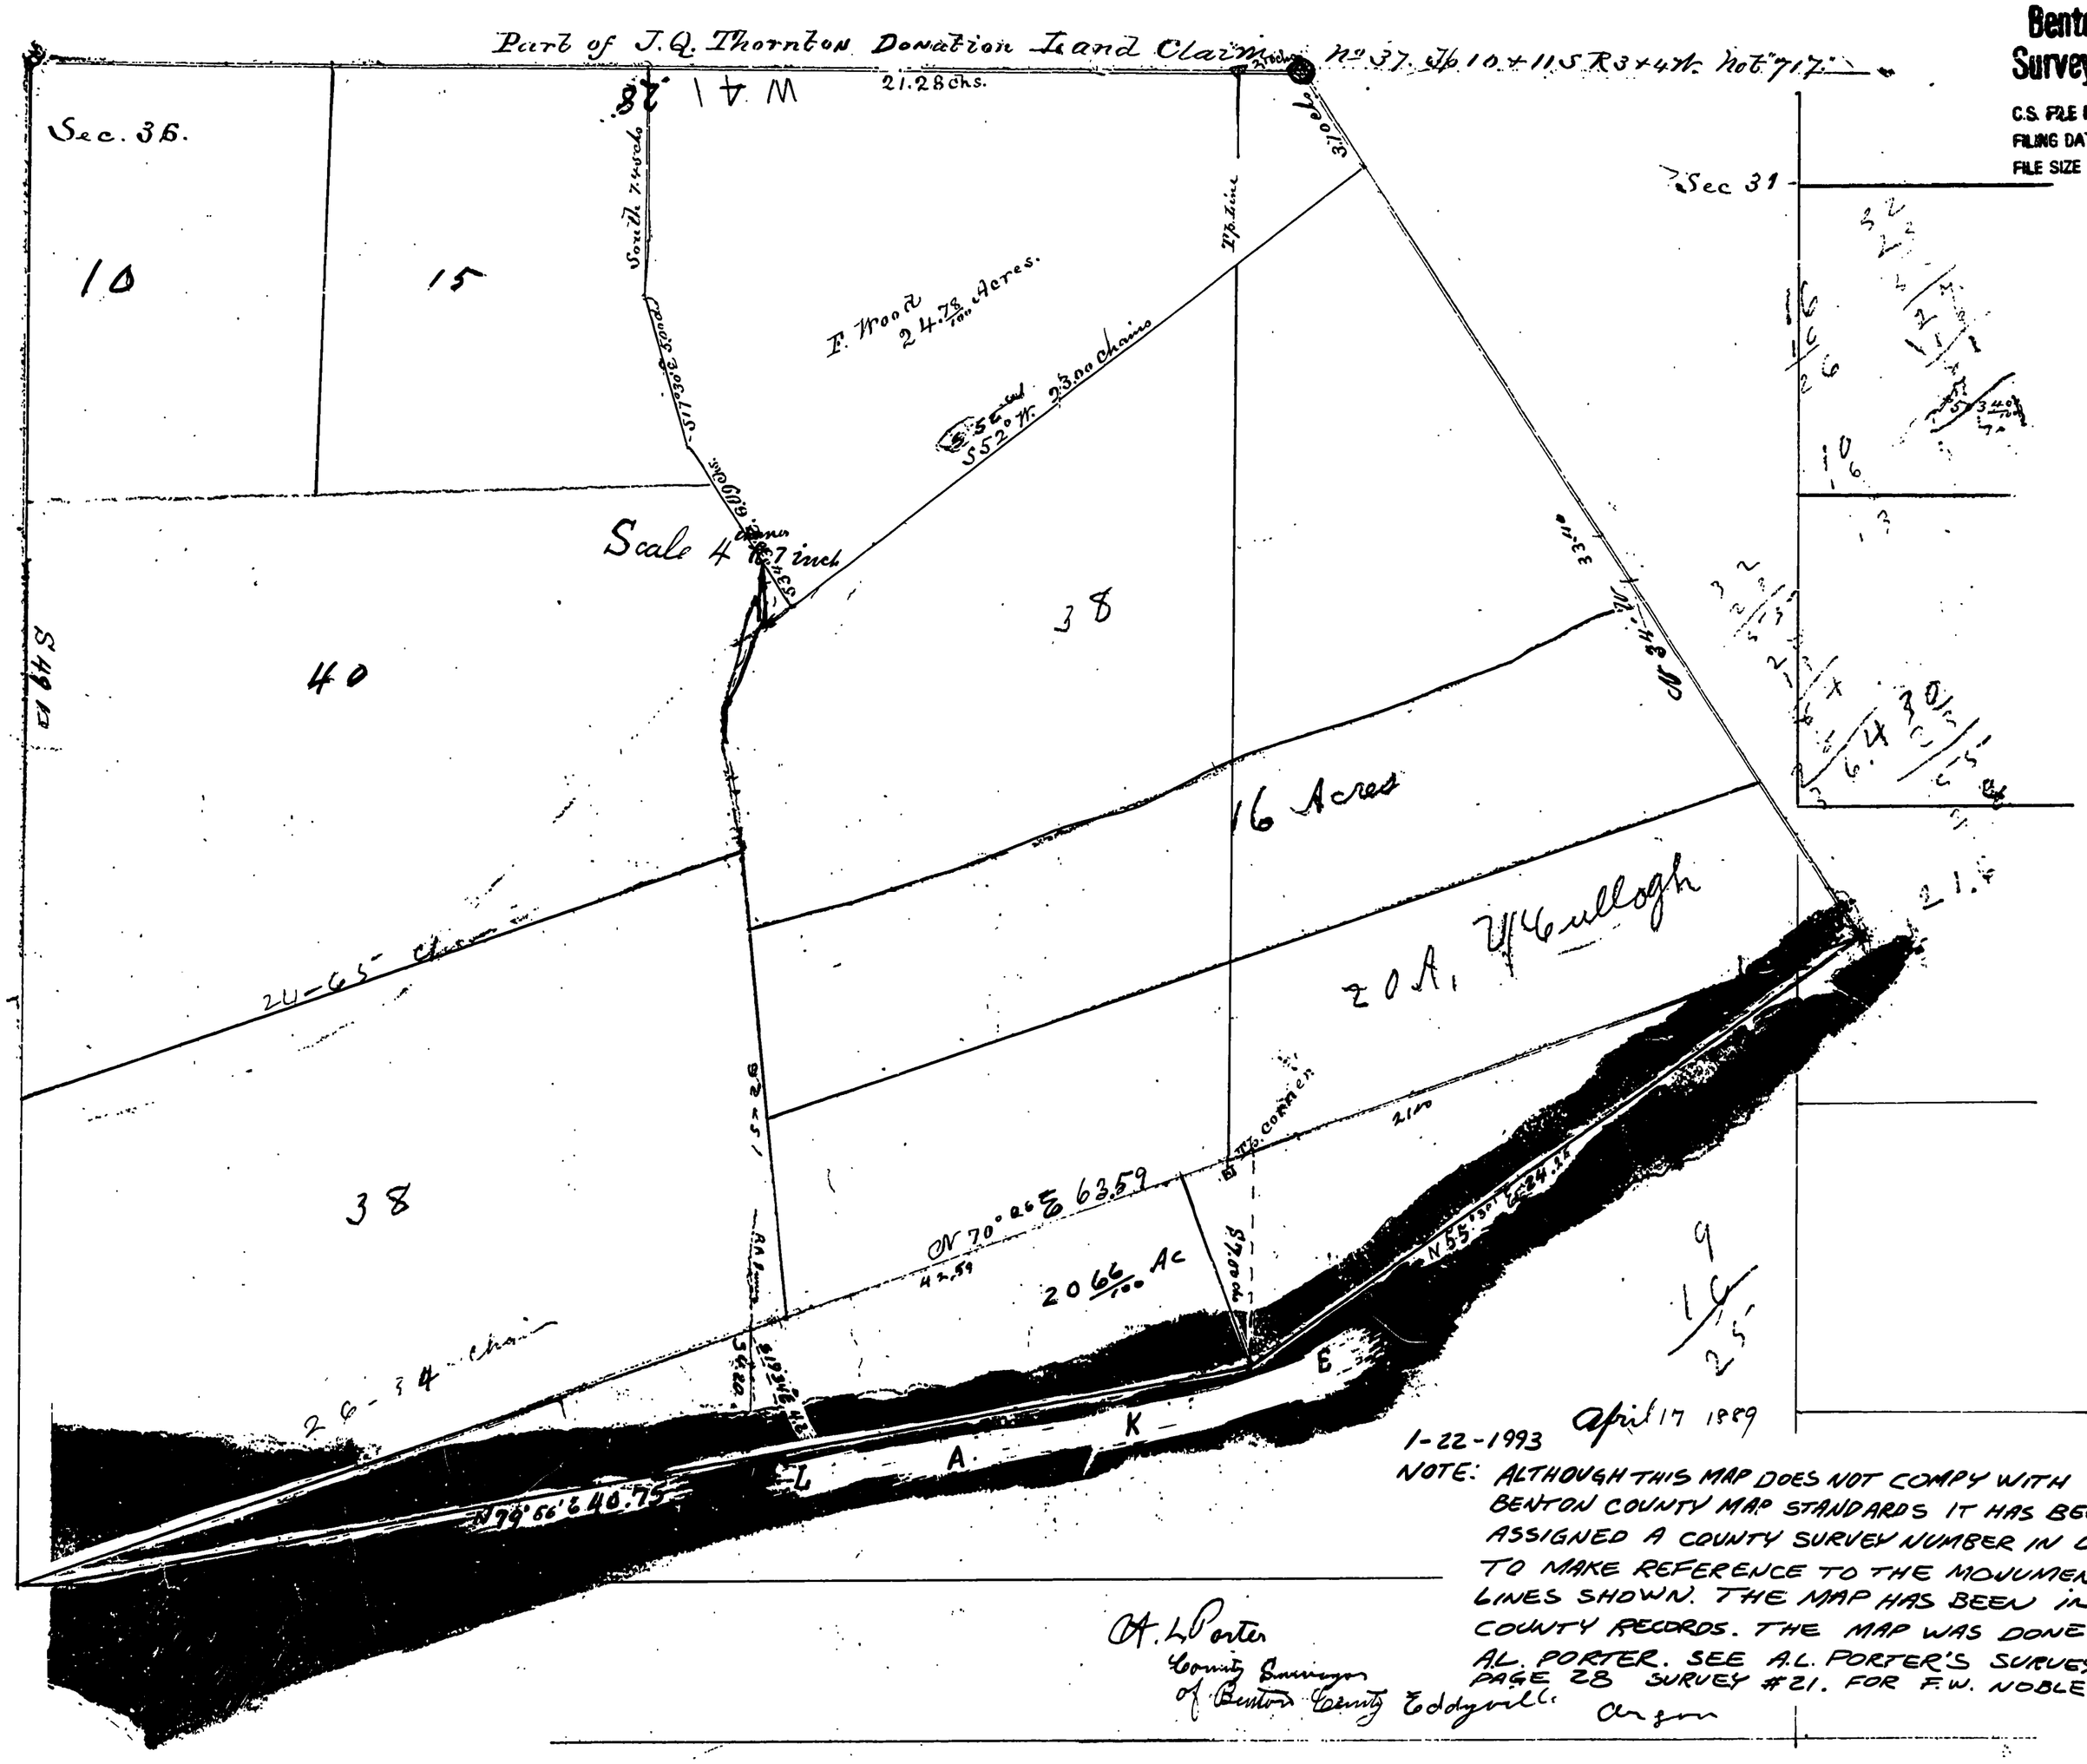

1-22-1993 April 17 1889

NOTE: ALTHOUGH THIS MAP DOES NOT COMPY WITH BENTON COUNTY MAP STANDARDS IT HAS BEEN ASSIGNED A COUNTY SURVEY NUMBER IN ORDER TO MAKE REFERENCE TO THE MONUMENTS AND LINES SHOWN. THE MAP HAS BEEN IN BENTON COUNTY RECORDS. THE MAP WAS DONE BY A.L. PORTER. SEE A.L. PORTER'S SURVEY BOOK PAGE 28 SURVEY #21. FOR F.W. NOBLE.

A. L. Porter
County Surveyor
of Benton County Eddyville
Oregon