Benton County
Surveyor's Office
C.S. FILE NO 10438
FILING DATE 9-8-10
FILE SIZE 11X17

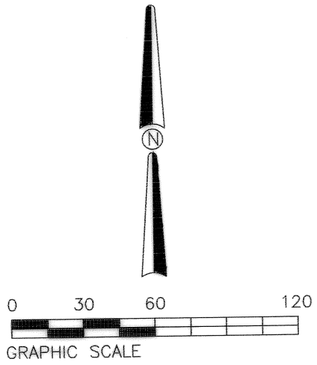

REGISTERED
PROFESSIONAL
LAND SURVEYOR
Darryl W. Harms
OREGON
JULY 30,1976
DARRYL W. HARMS
1079
RENEWAL DATE 6/30/11

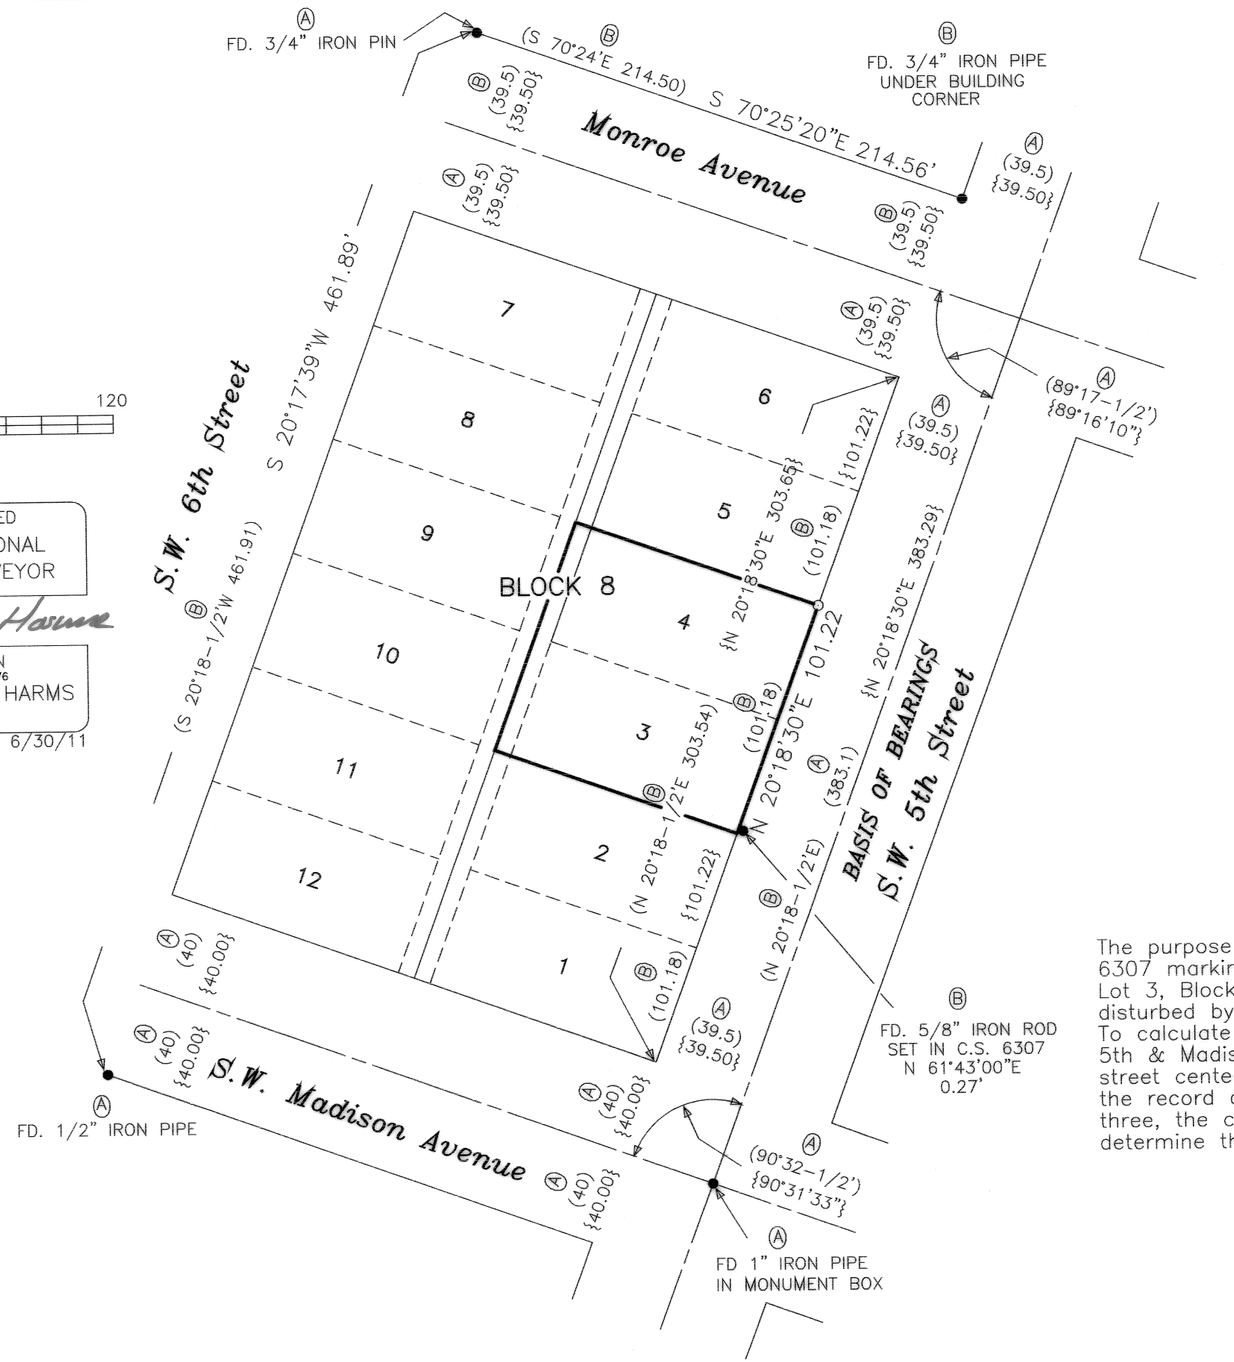

MAP OF SURVEY FOR Mid-Valley Gravel Co.

SEPT. 6, 2010

BLOCK 8, COUNTY ADDITION,
S.W. 1/4 SECTION 35,
T.11 S., R.5 W., W.M.,
CITY OF CORVALLIS,
BENTON COUNTY,
OREGON.

LEGEND

- ● MONUMENT FOUNT, TYPE & REFERENCE NOTED
- ○ SET 2-1/2" MAGNAIL WITH 1-1/4" ALUMINUM WASHER STAMPED "D.W. HARMS, P.L.S. 1079" IN TOP OF CURB BEHIND SIDEWALK.
- ( ) RECORD DATA, REFERENCE NOTED
- { } CALCULATED DATA
- Ⓐ GALLOWAY CITY PLAT 00011
- Ⓑ C.S. 6307

NARRATIVE

The purpose of this survey is to verify the monuments set in C.S. 6307 marking the Northeast corner of Lot 4 and the Southeast corner of Lot 3, Block 8, County Addition, the monuments were removed or disturbed by recent construction activities.
To calculate the street centerlines I held the centerline monument at 5th & Madison and record distance from the other found monuments to street centerlines, I then computed the NE & SE corners of Block 8 at the record distances from the calculated centerlines and divided, by three, the computed distance between the NE & SE corners of Block 8 to determine the position of the monuments set.

DARRYL W. HARMS, P.L.S.
P.O. BOX 1051
CORVALLIS, OR 97339
PHONE: (541) 745-3948
E-MAIL
darrylharms@proaxis.com