ORIGINAL

CS 129
26

OTTO H. MEYER
CIVIL ENGINEER
621 North 35th Street
CORVALLIS, OREGON

1837

Dec. 26, 1946

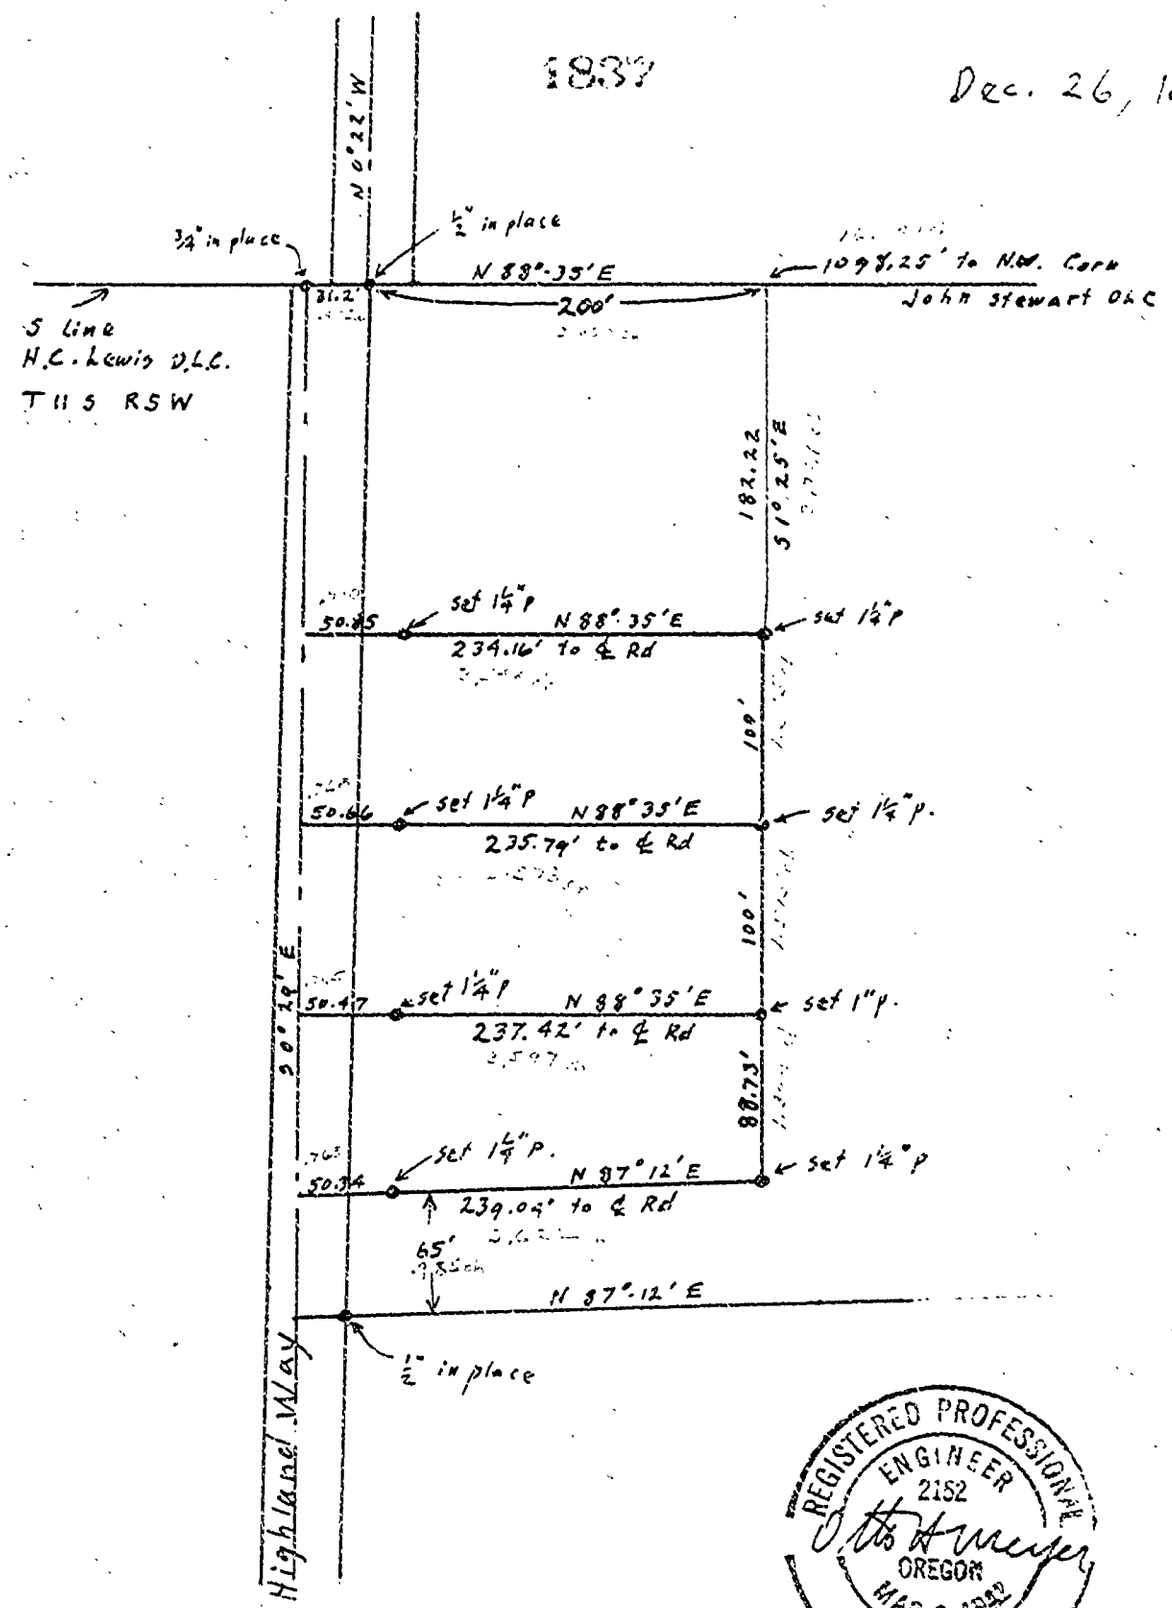

REGISTERED PROFESSIONAL ENGINEER 2182 OREGON MAR. 5, 1942 OTTO H. MEYER

Platted M.L.B.