NE. 4D Avery

OTTO H. MEYER
CIVIL ENGINEER
621 North 35th Street
CORVALLIS, OREGON

2039

Aug. 10, 1948

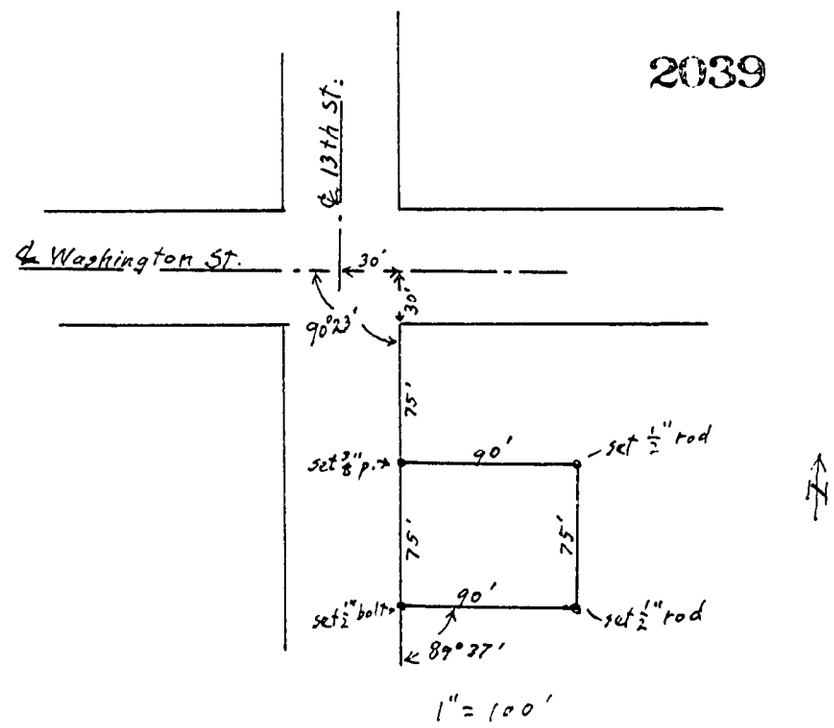

Survey of W 90 ft. of Lot 3 & S ½ of Lot 2, Block 13
N. B. & P. Avery's Addition

REGISTERED PROFESSIONAL ENGINEER 2152 OREGON MAR. 6, 1942 OTTO H. MEYER