2321

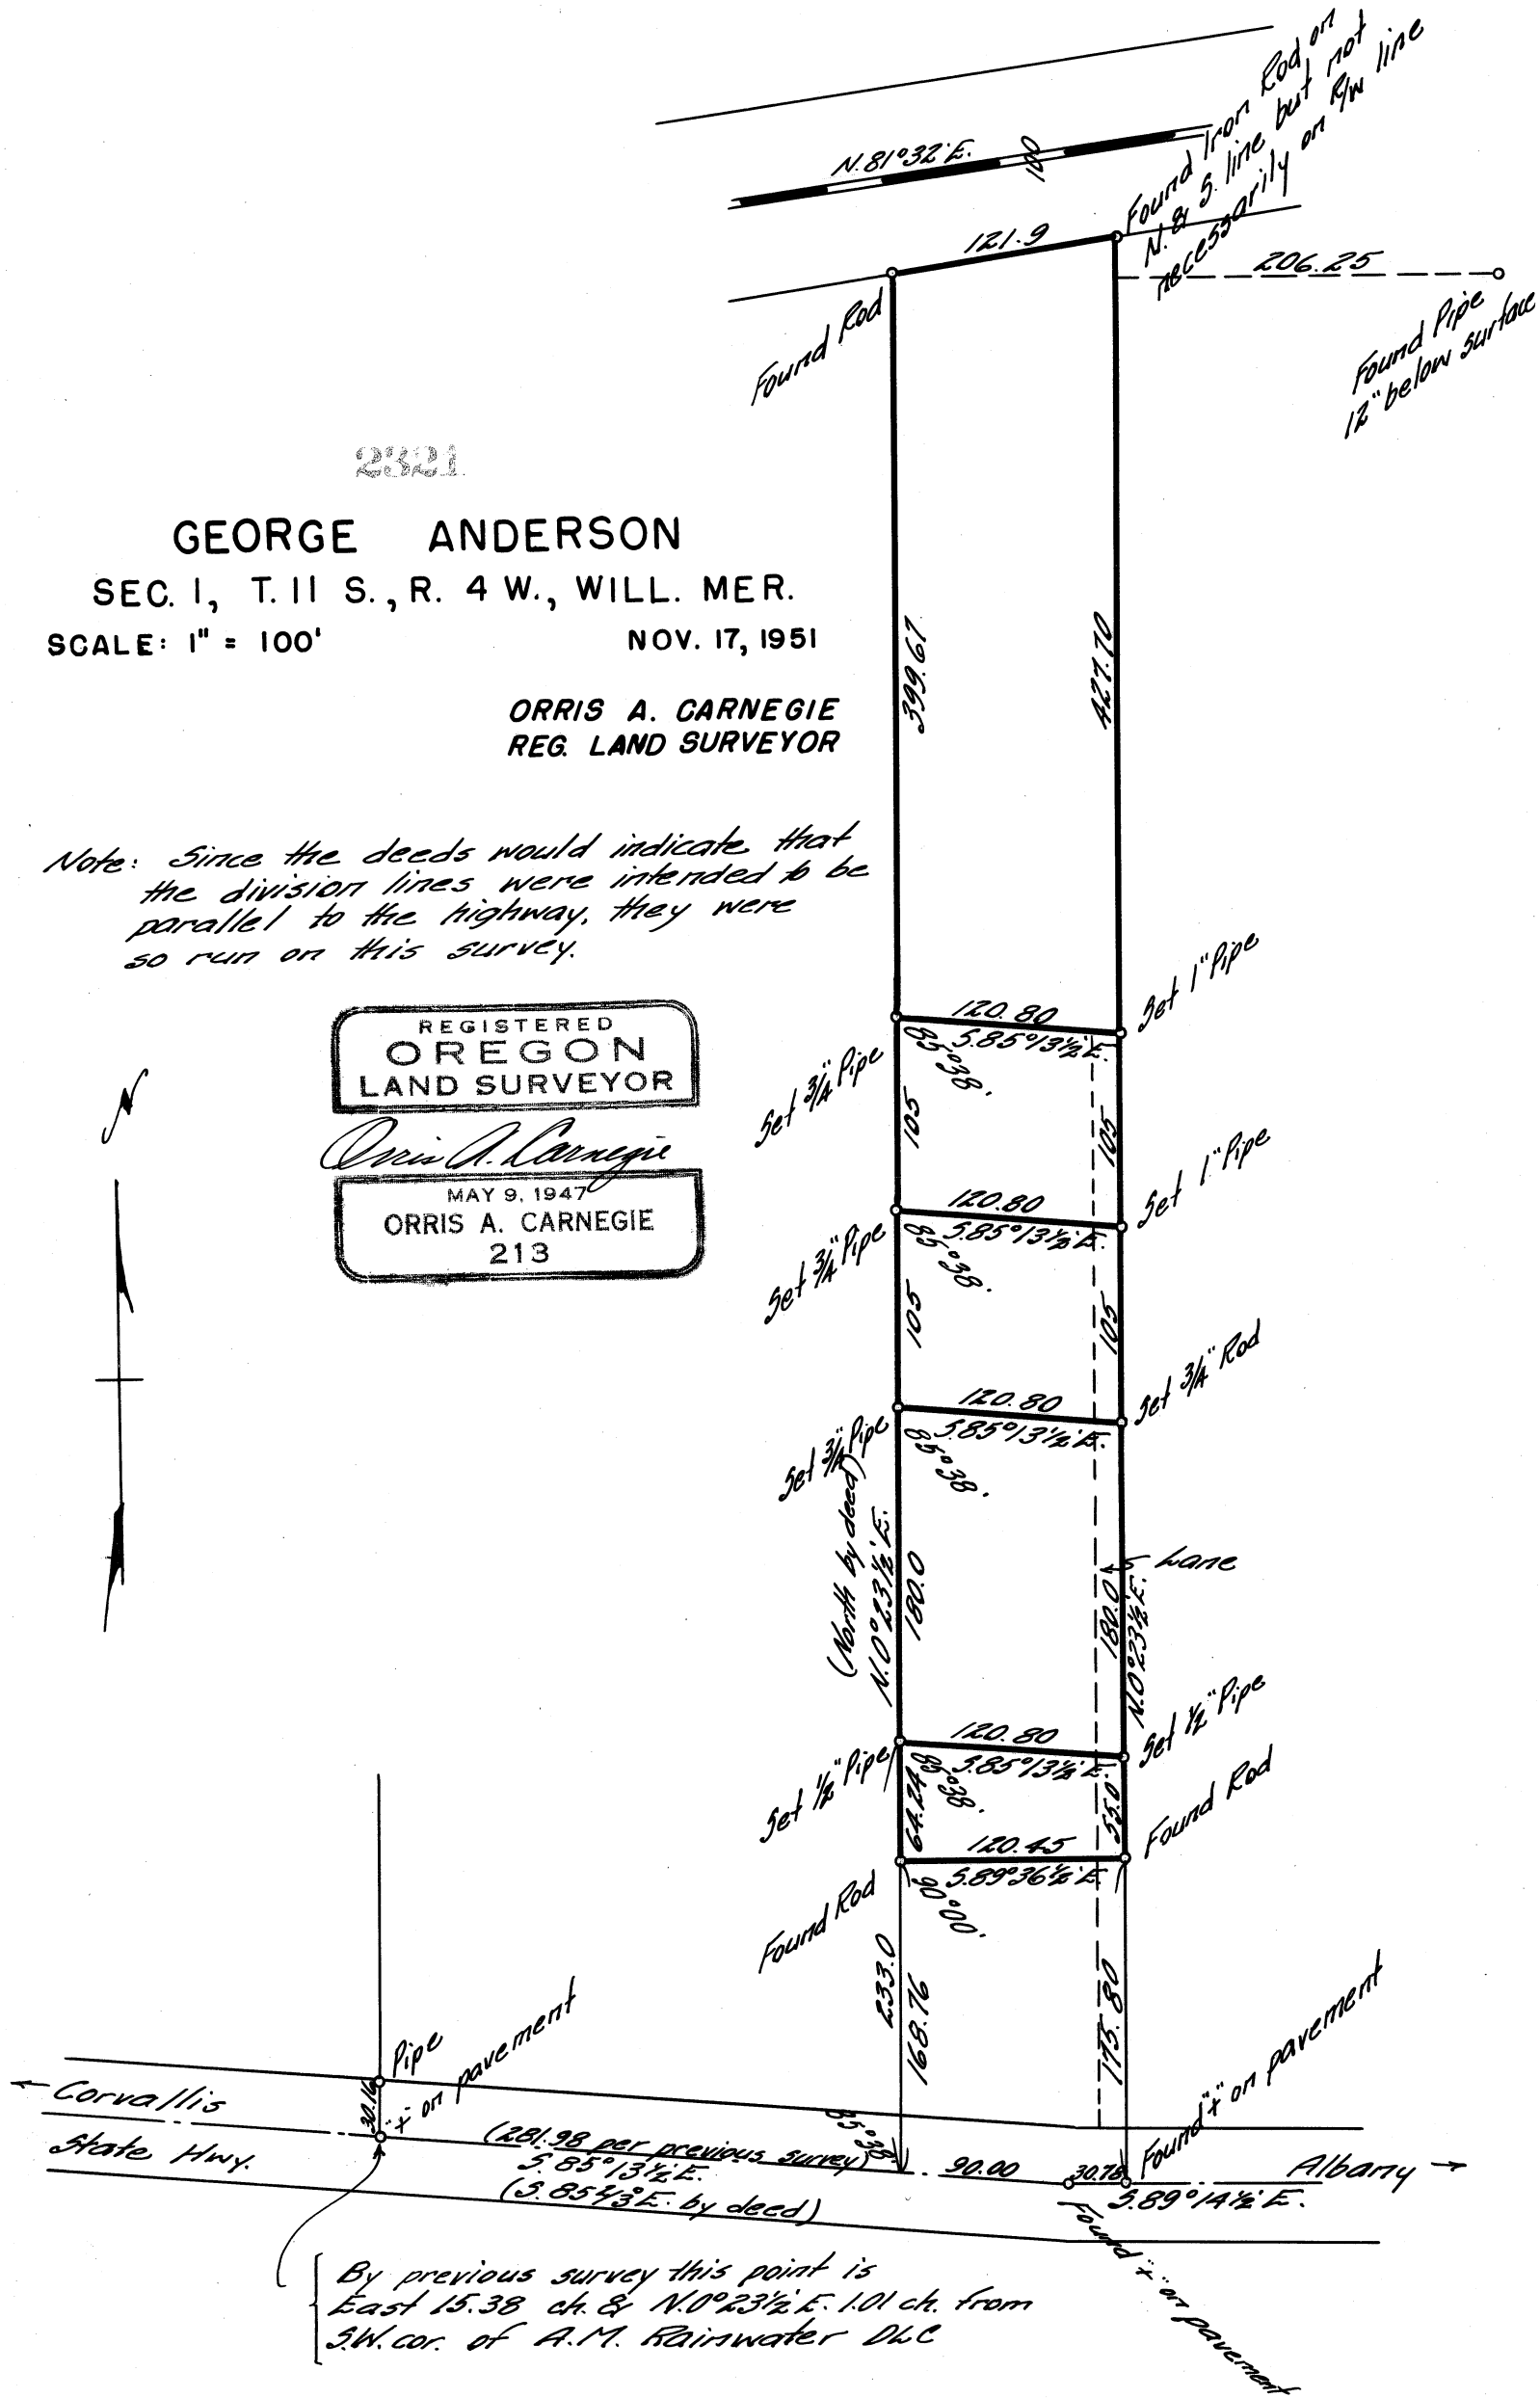

2321

GEORGE ANDERSON

SEC. 1, T. 11 S., R. 4 W., WILL. MER.

SCALE: 1" = 100'

NOV. 17, 1951

ORRIS A. CARNEGIE
REG. LAND SURVEYOR

Note: Since the deeds would indicate that the division lines were intended to be parallel to the highway, they were so run on this survey.

REGISTERED
OREGON
LAND SURVEYOR

Orris A. Carnegie

MAY 9, 1947
ORRIS A. CARNEGIE
213

By previous survey this point is East 15.38 ch. & N.0°23½'E. 1.01 ch. from S.W. cor. of A.M. Rainwater DLC