2524

2524

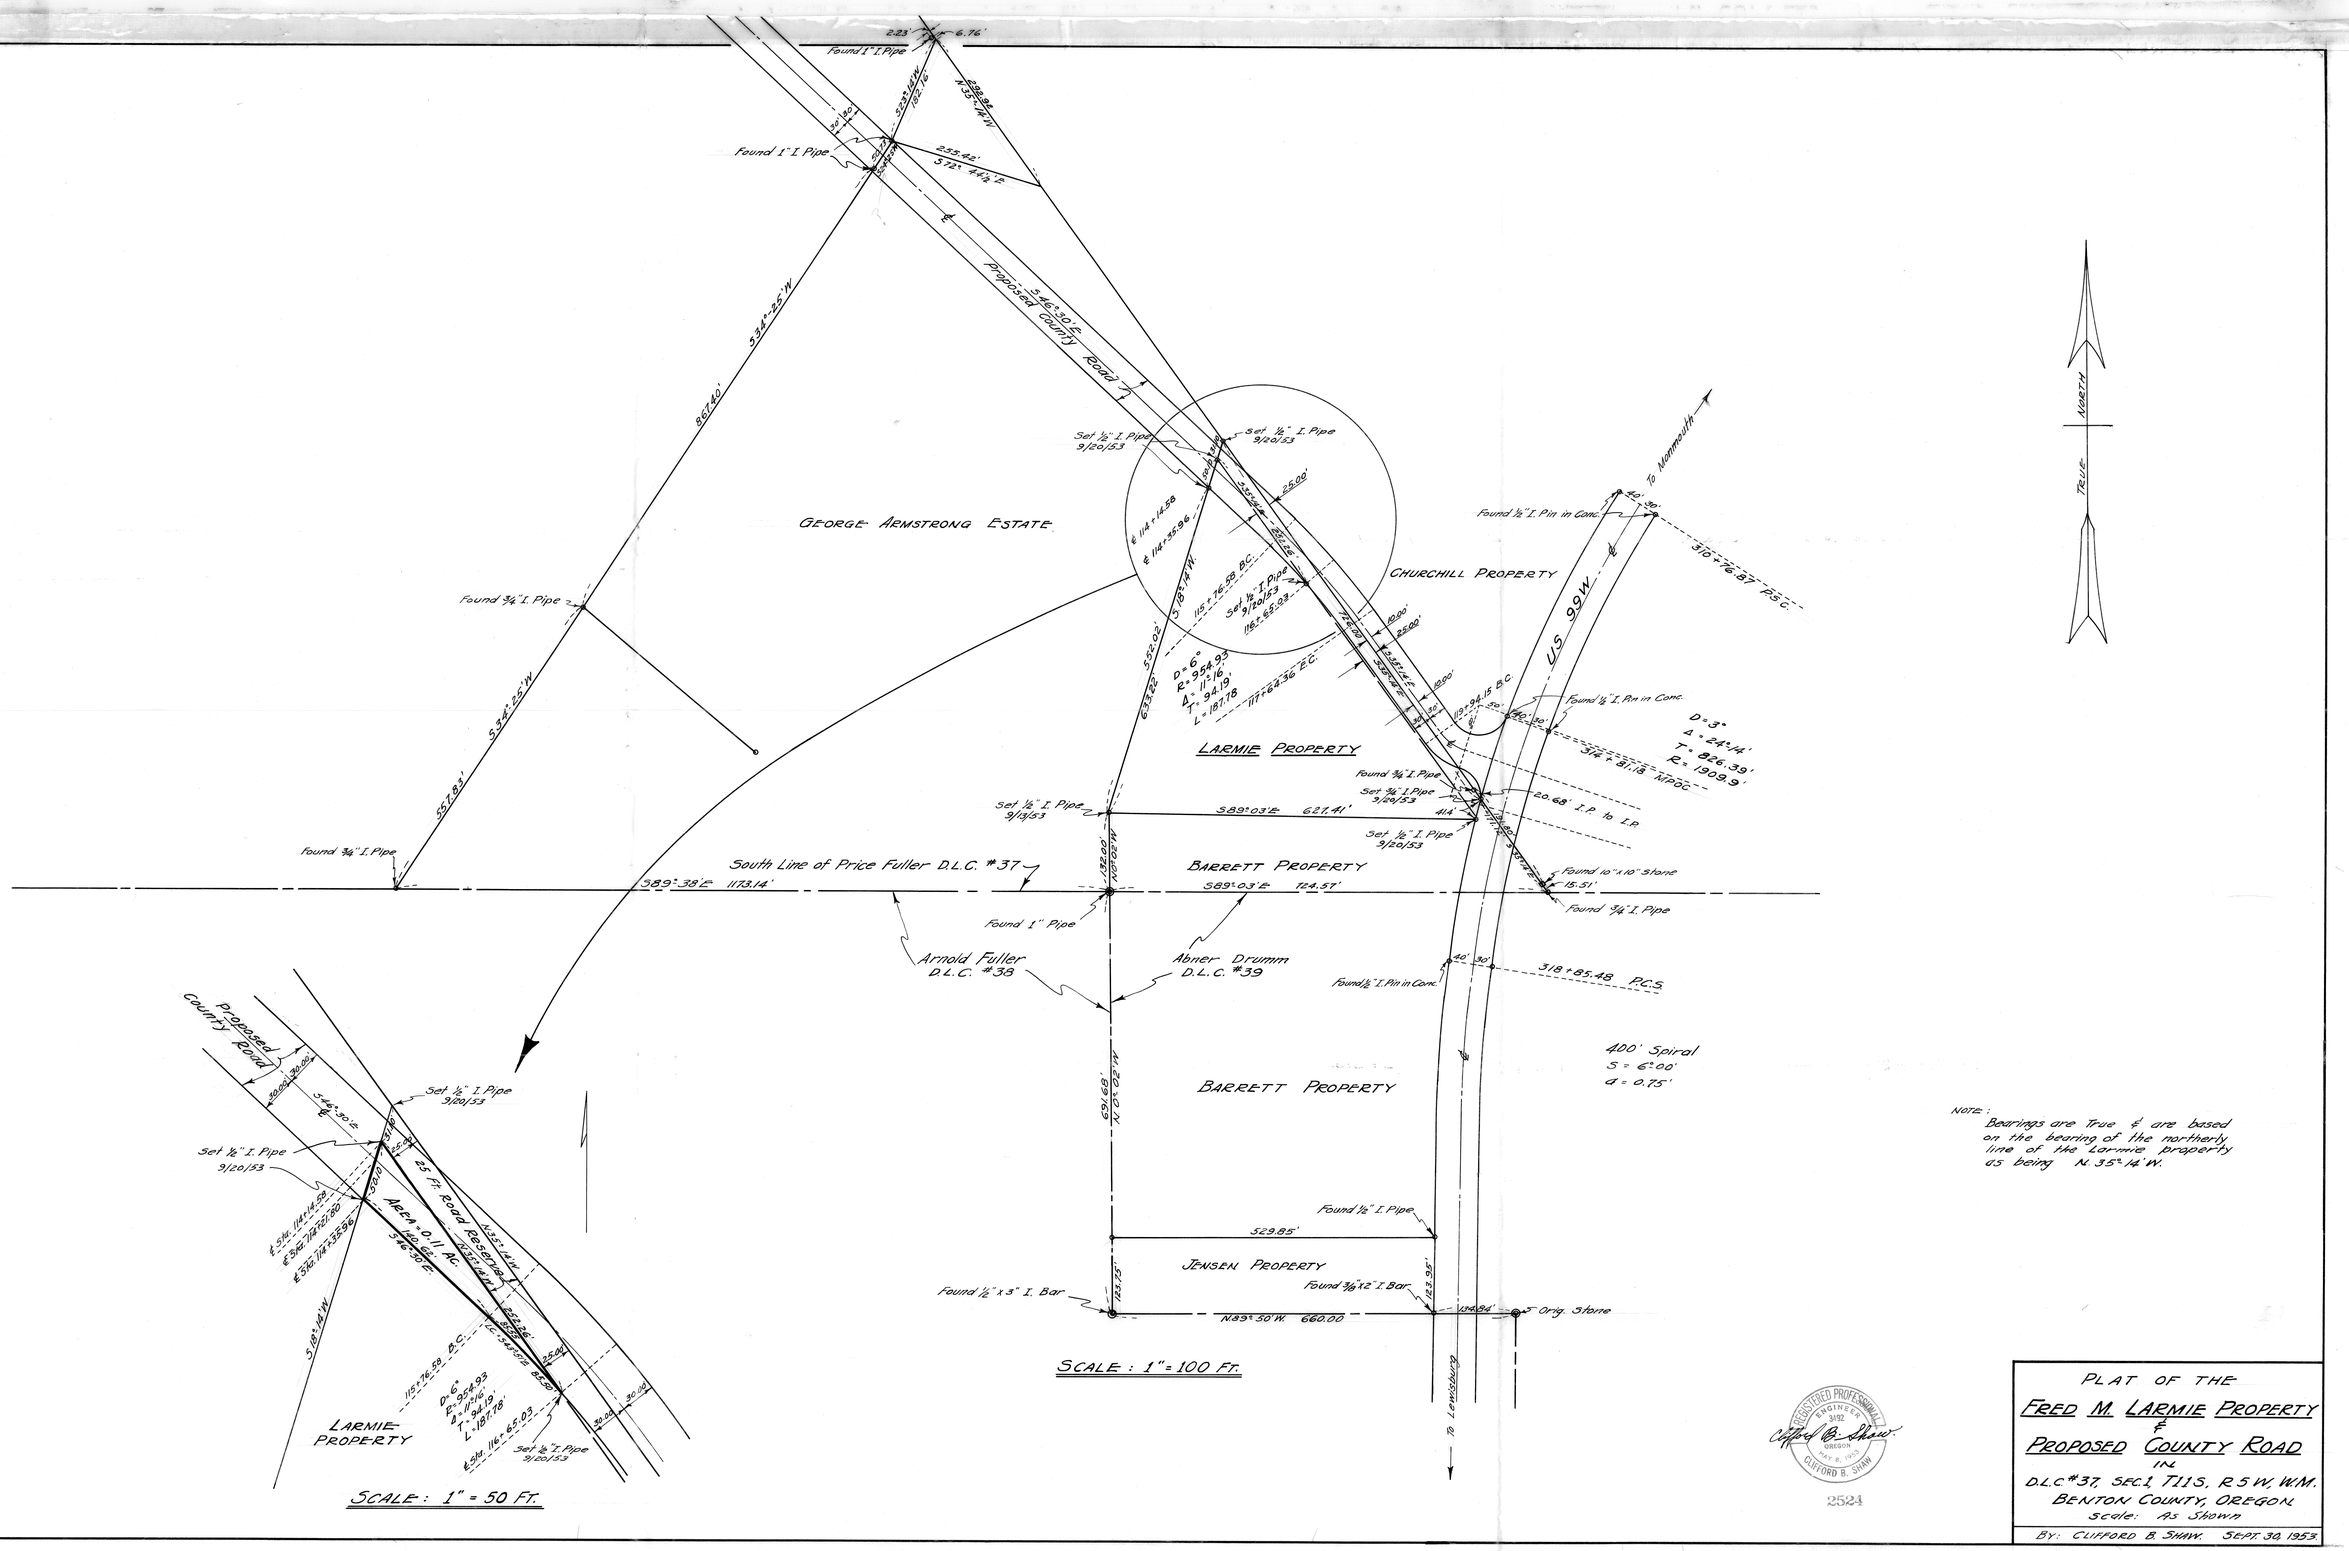

SCALE : 1" = 50 Ft.

SCALE : 1" = 100 Ft.

Note: Bearings are True ℄ are based on the bearing of the northerly line of the Larmie property as being N. 35°-14' W.

REGISTERED PROFESSIONAL ENGINEER OREGON MAY 8, 1951 CLIFFORD B. SHAW

2524

PLAT OF THE
FRED M. LARMIE PROPERTY
&
PROPOSED COUNTY ROAD
IN
D.L.C #37, SEC. 1 T11S, R5W, W.M.
BENTON COUNTY, OREGON.
Scale: As Shown

BY: CLIFFORD B. SHAW. SEPT. 30, 1953

2524