Sec. 36, T. 10 S., R 4 W., Will. Mer.

Scale: 1" = 2ch. Aug. 22, 1954.

2617

REGISTERED
OREGON
LAND SURVEYOR
Martin L. Beyerlein
NOV. 5, 1948
MARTIN L. BEYERLEIN
247

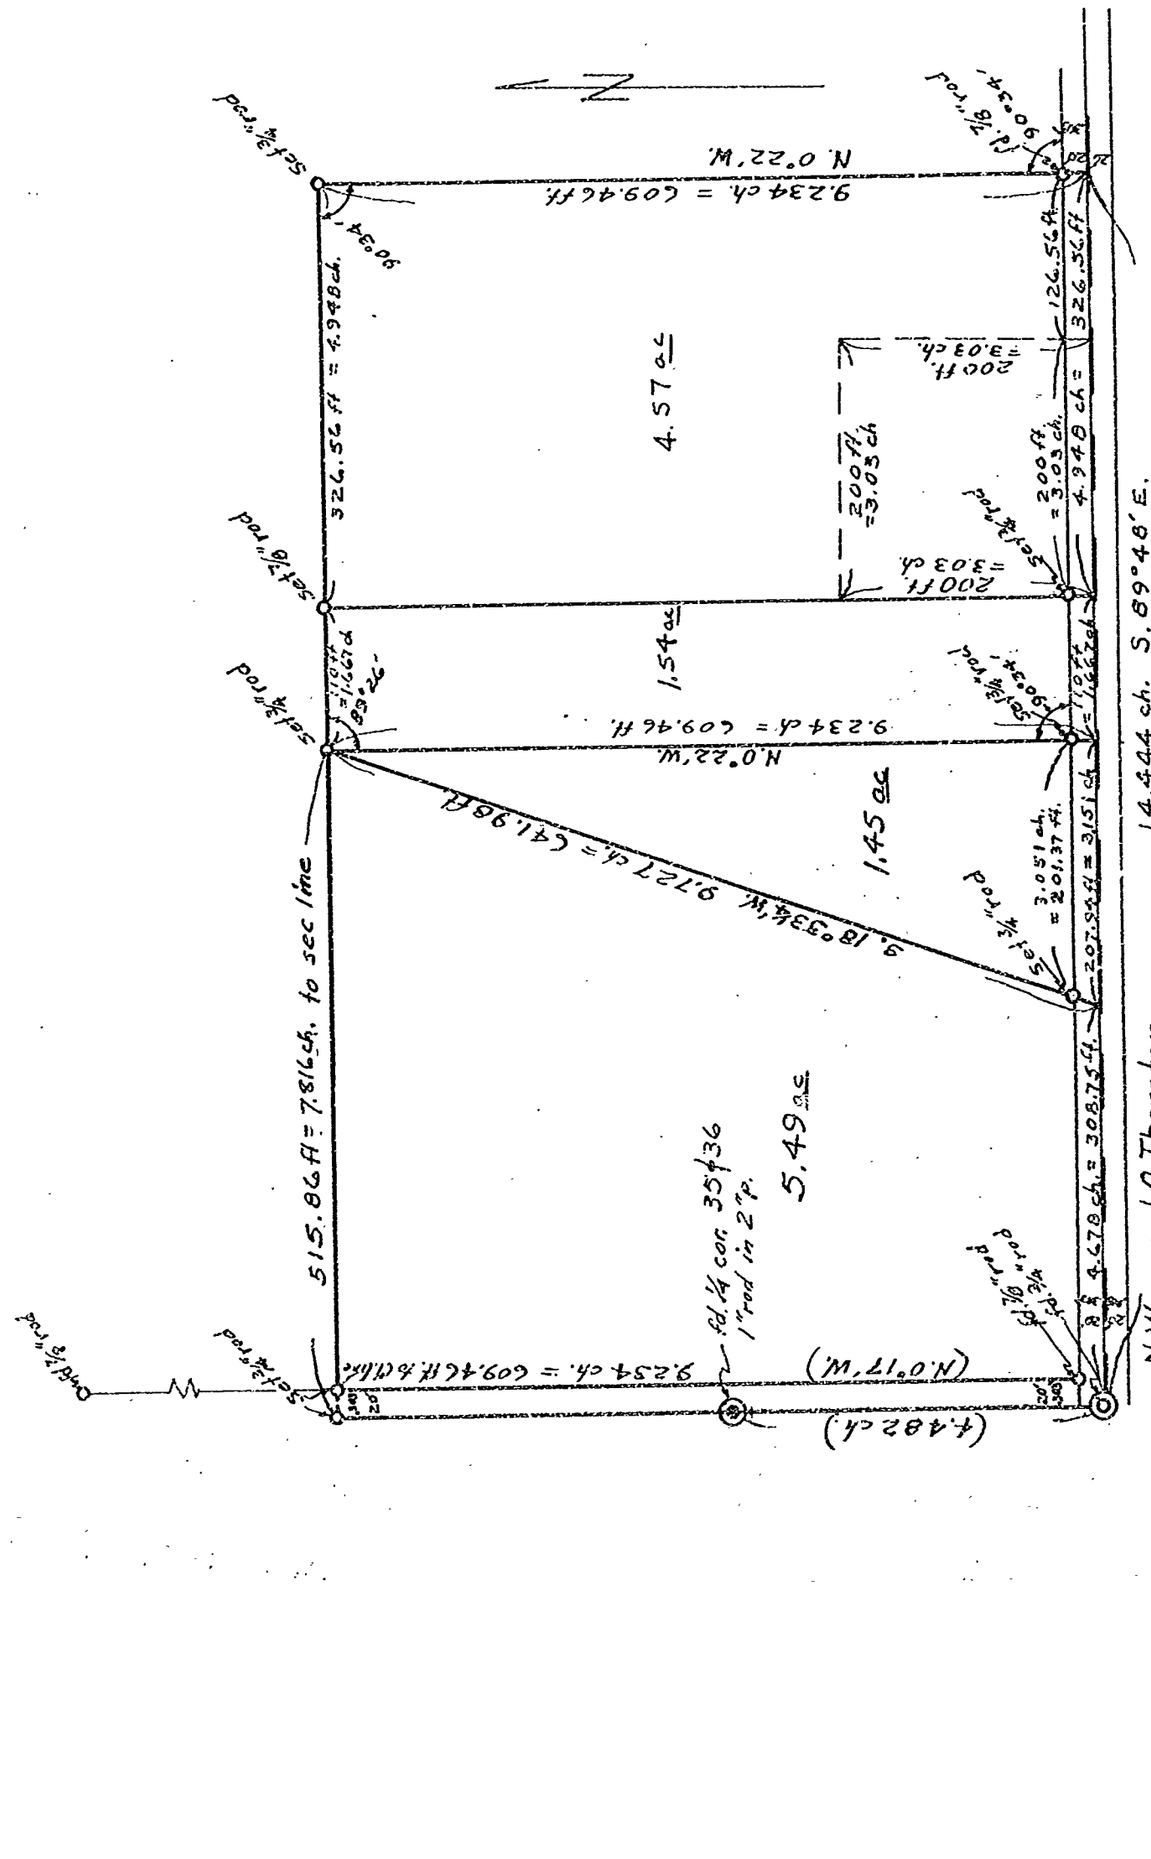

CATHERINE BAIN

Sec. 36, T. 10 S., R. 4 W., Will. Mer.

Scale: 1" = 2ch. Aug. 22, 1954.

2617
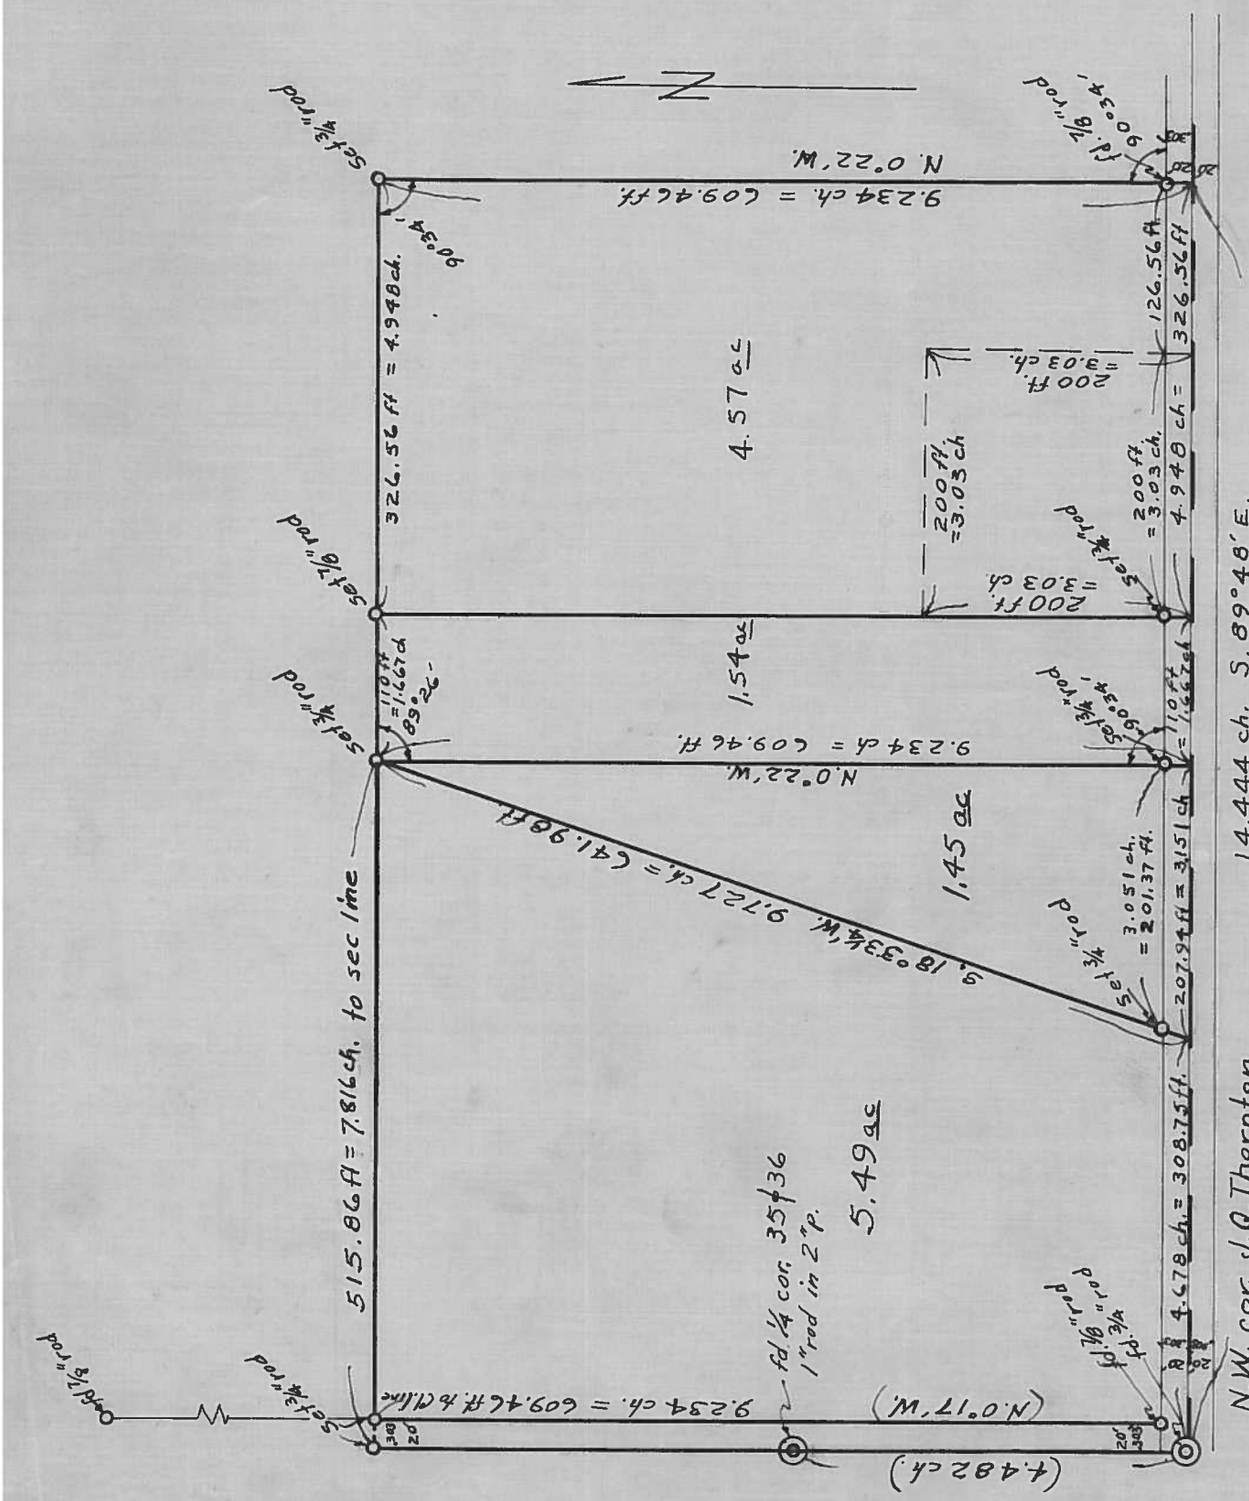
REGISTERED
OREGON
LAND SURVEYOR
Martin L. Beyerlein
NOV. 5, 1948
MARTIN L. BEYERLEIN
247