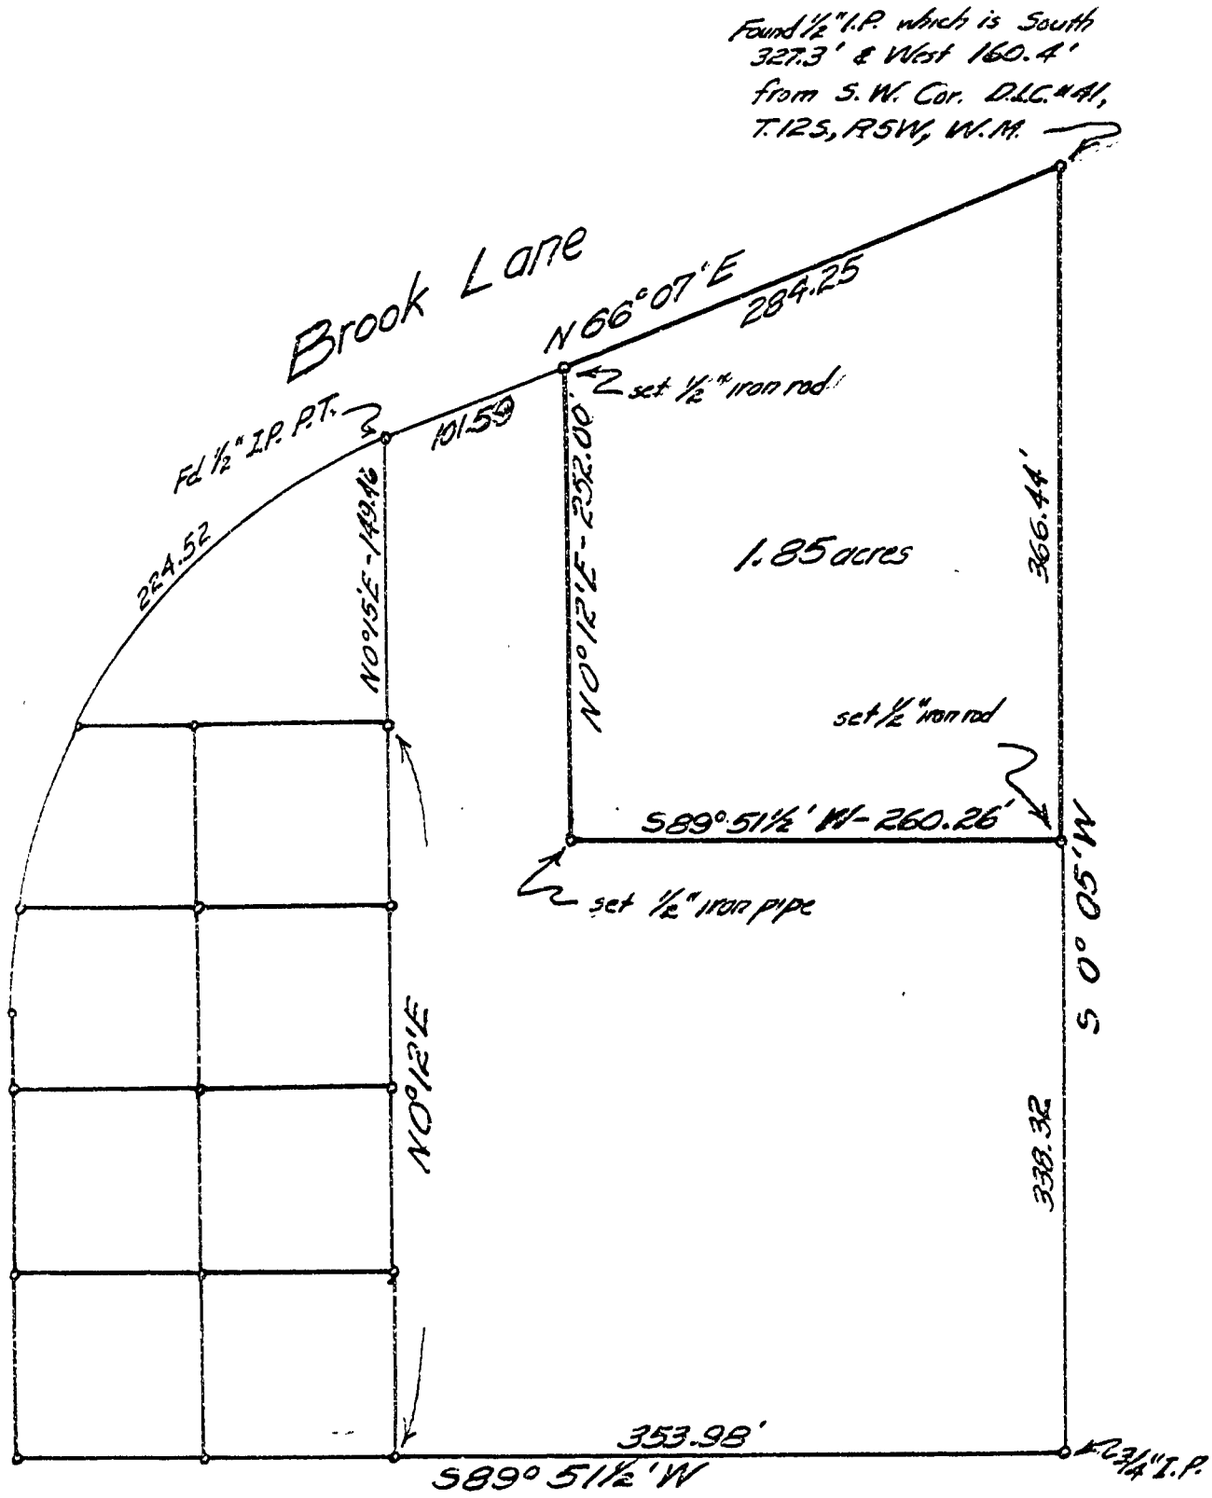

C.S. No. 3043

Survey
for
Chas. Stratton
in
Sec 3 & 10, T12S, R5W, W.M.

C.W. Dane
Corvallis, Ore.

Scale 1 in. = 100 ft
April 1958

C.W. Dane

Bearings based on survey by O.H.M. of 11/27/54.