ED TUCHEK
Part of Section 31
T. 10S., R. 3 W., of W.M.
Benton County, Oregon
Scale 1" = 50'
Surveyed July 14, 1958
C. S. No. 3072

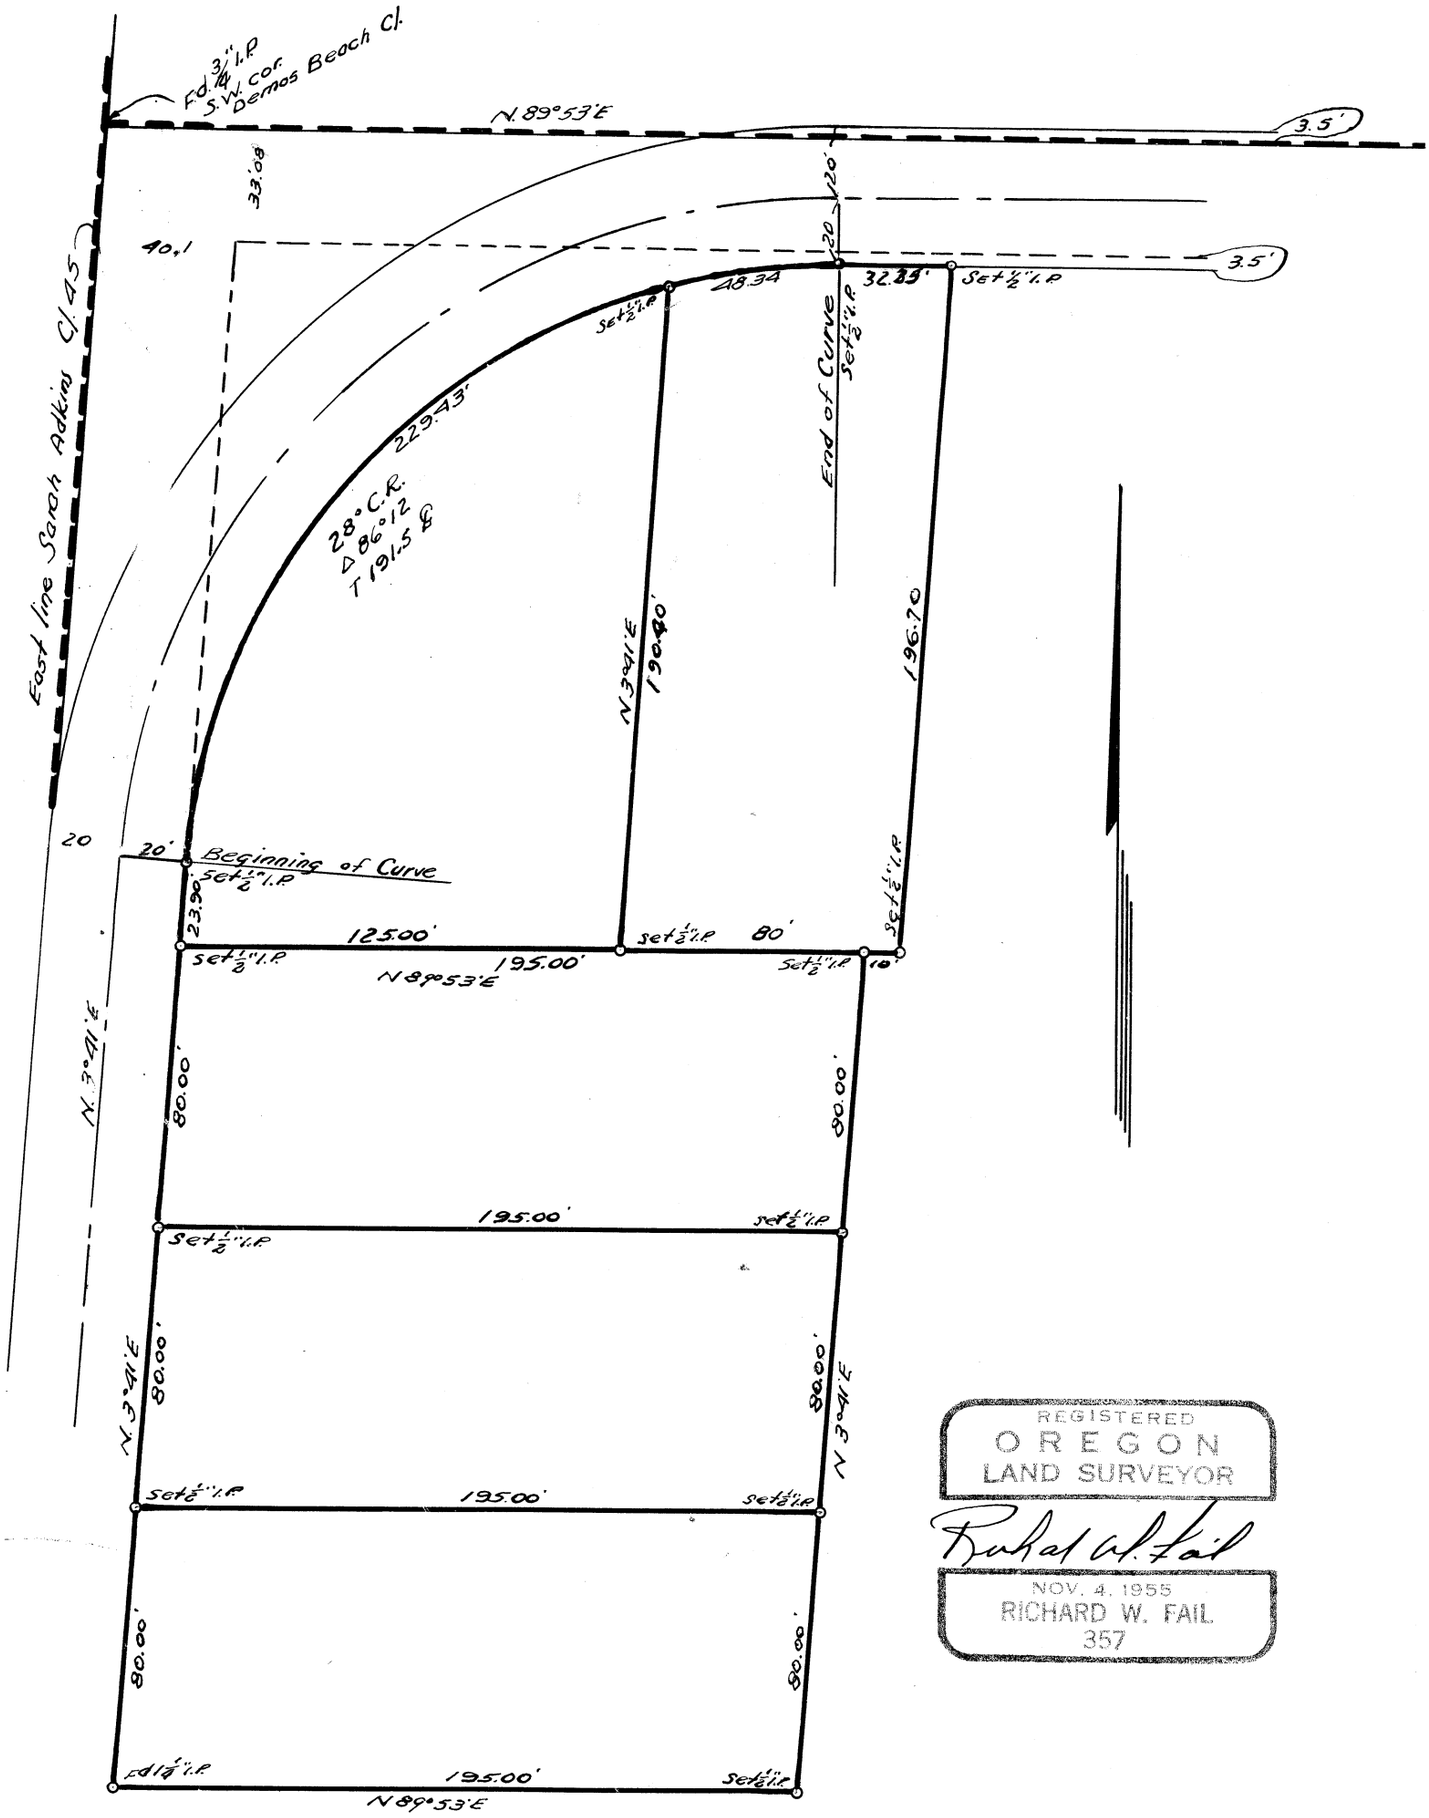

REGISTERED
OREGON
LAND SURVEYOR

Richard W. Fail

NOV. 4, 1955
RICHARD W. FAIL
357