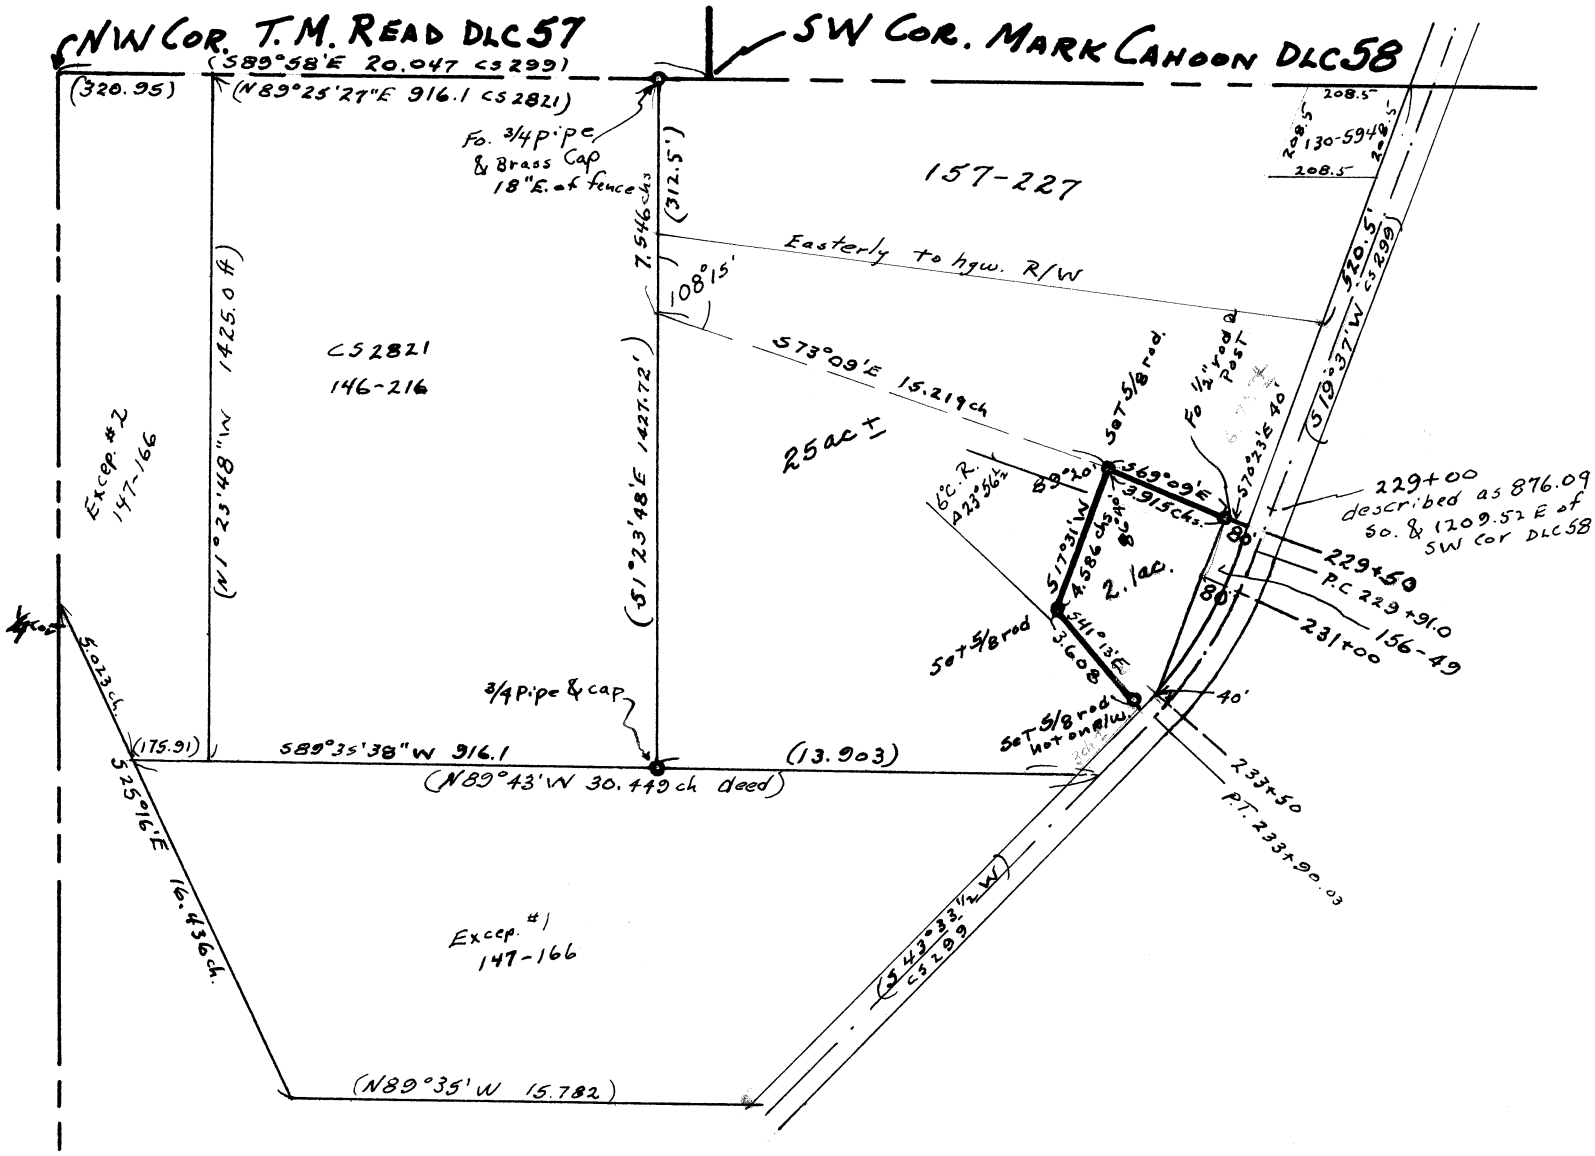

Bert W. Udell

CS 3290

RICHARD McGUIRE

DLC 57, SEC. 31, T10S, R4W.

Scale 1" = 6 chs.

9/5/59

BERT UDELL
R.P.E. # 2301

bearings from CS 2821