C.S. 3583

SURVEY FOR BERT SMITH IN SECTION 19, T11S, R5W OF WILLAMETTE MERIDIAN BENTON COUNTY, OREGON

SCALE 1" = 100'

APRIL 12, 1960

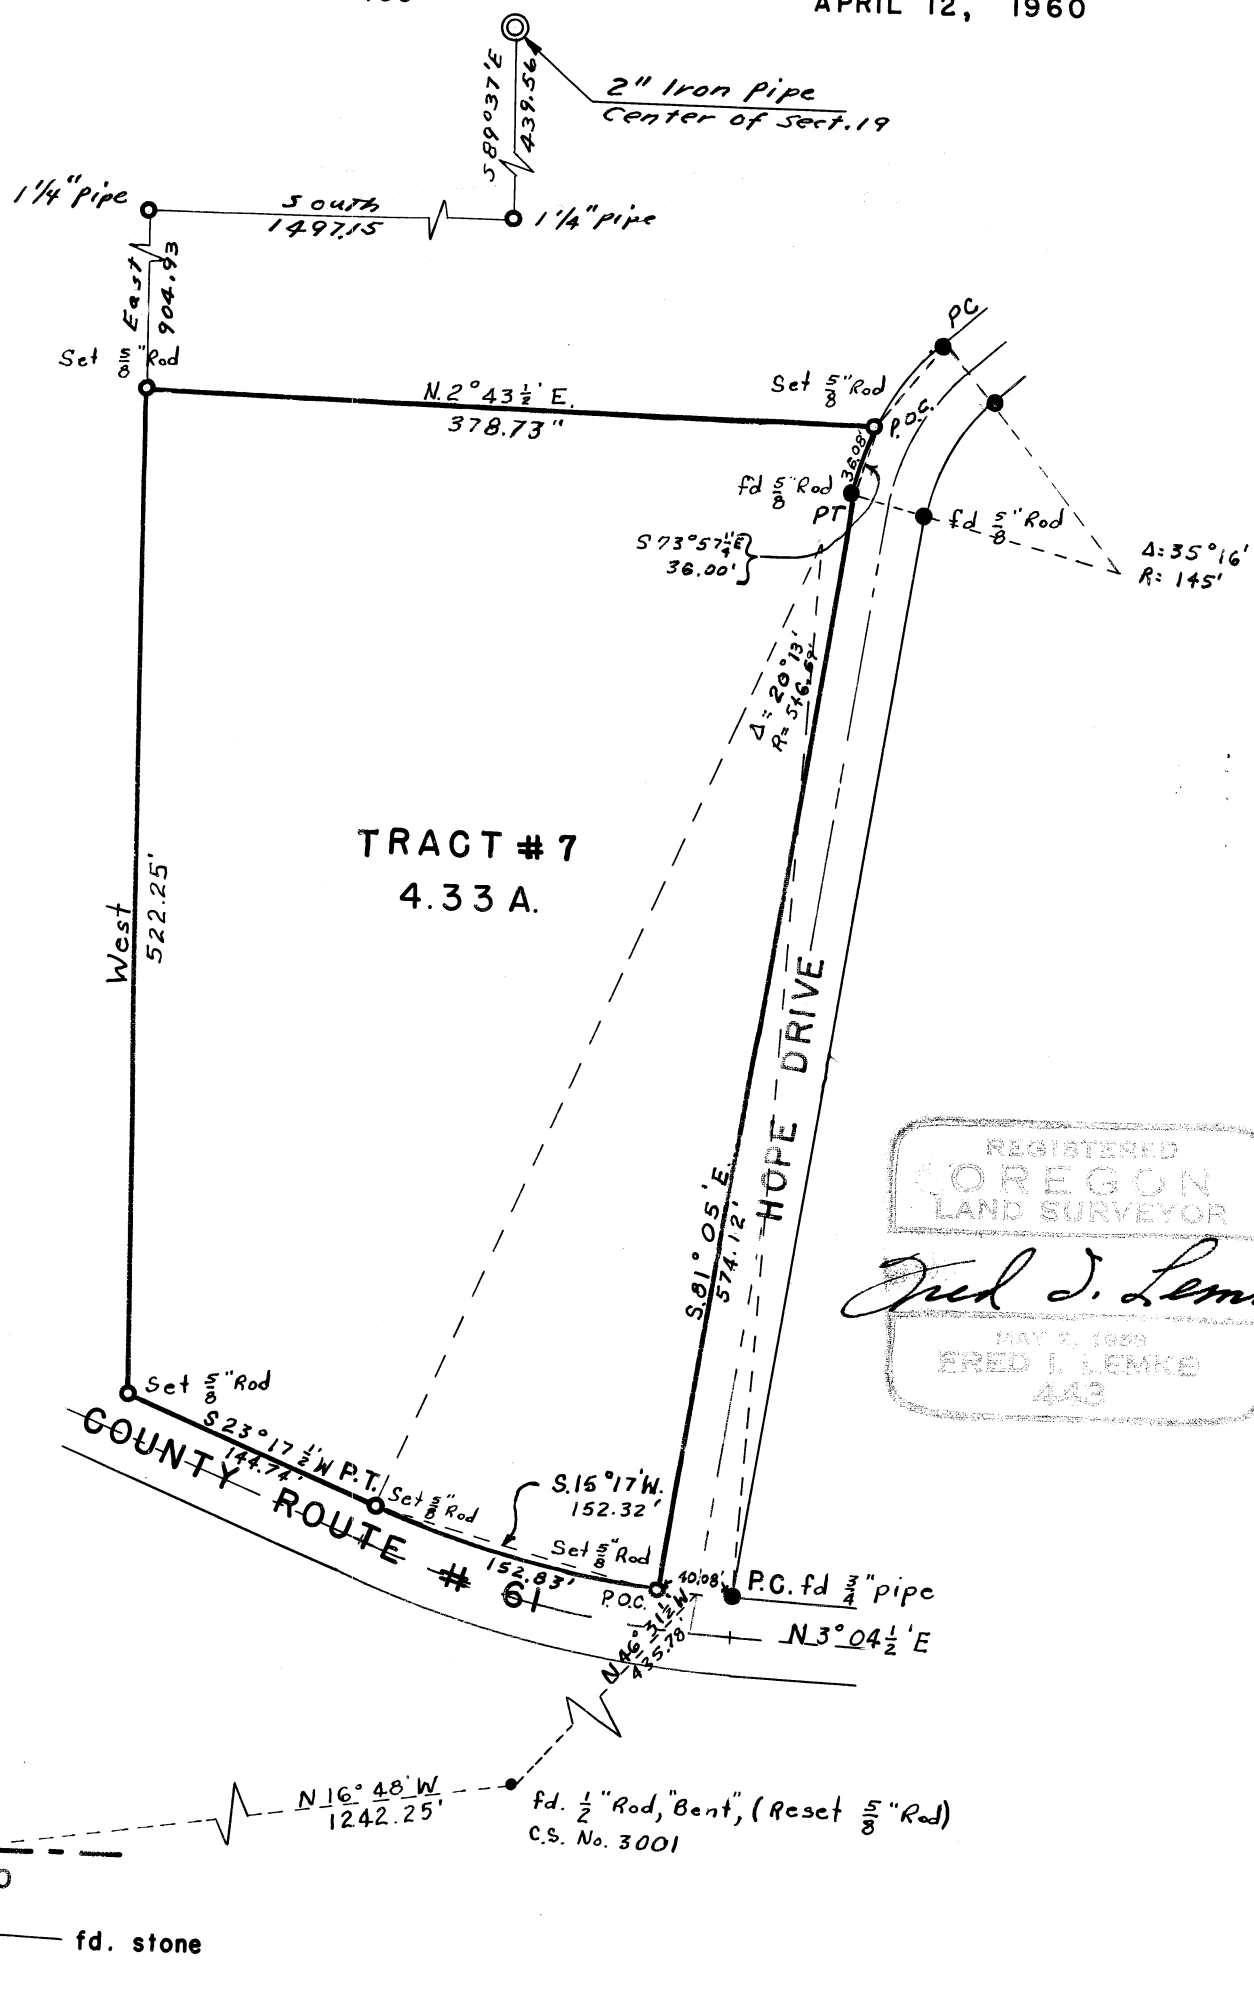

REGISTERED
OREGON
LAND SURVEYOR

Fred J. Lemke

MAY 9, 1960
FRED J. LEMKE
443