C.S. 3825

Record of Survey for
Ralph L. Carmichael
Part of the Charles Johnson Cl.40
T.12 S.,R.5 W.,of the Will. Mer.
Benton County, Oregon

Surveyed July 25,1963
Scale 1"-30'

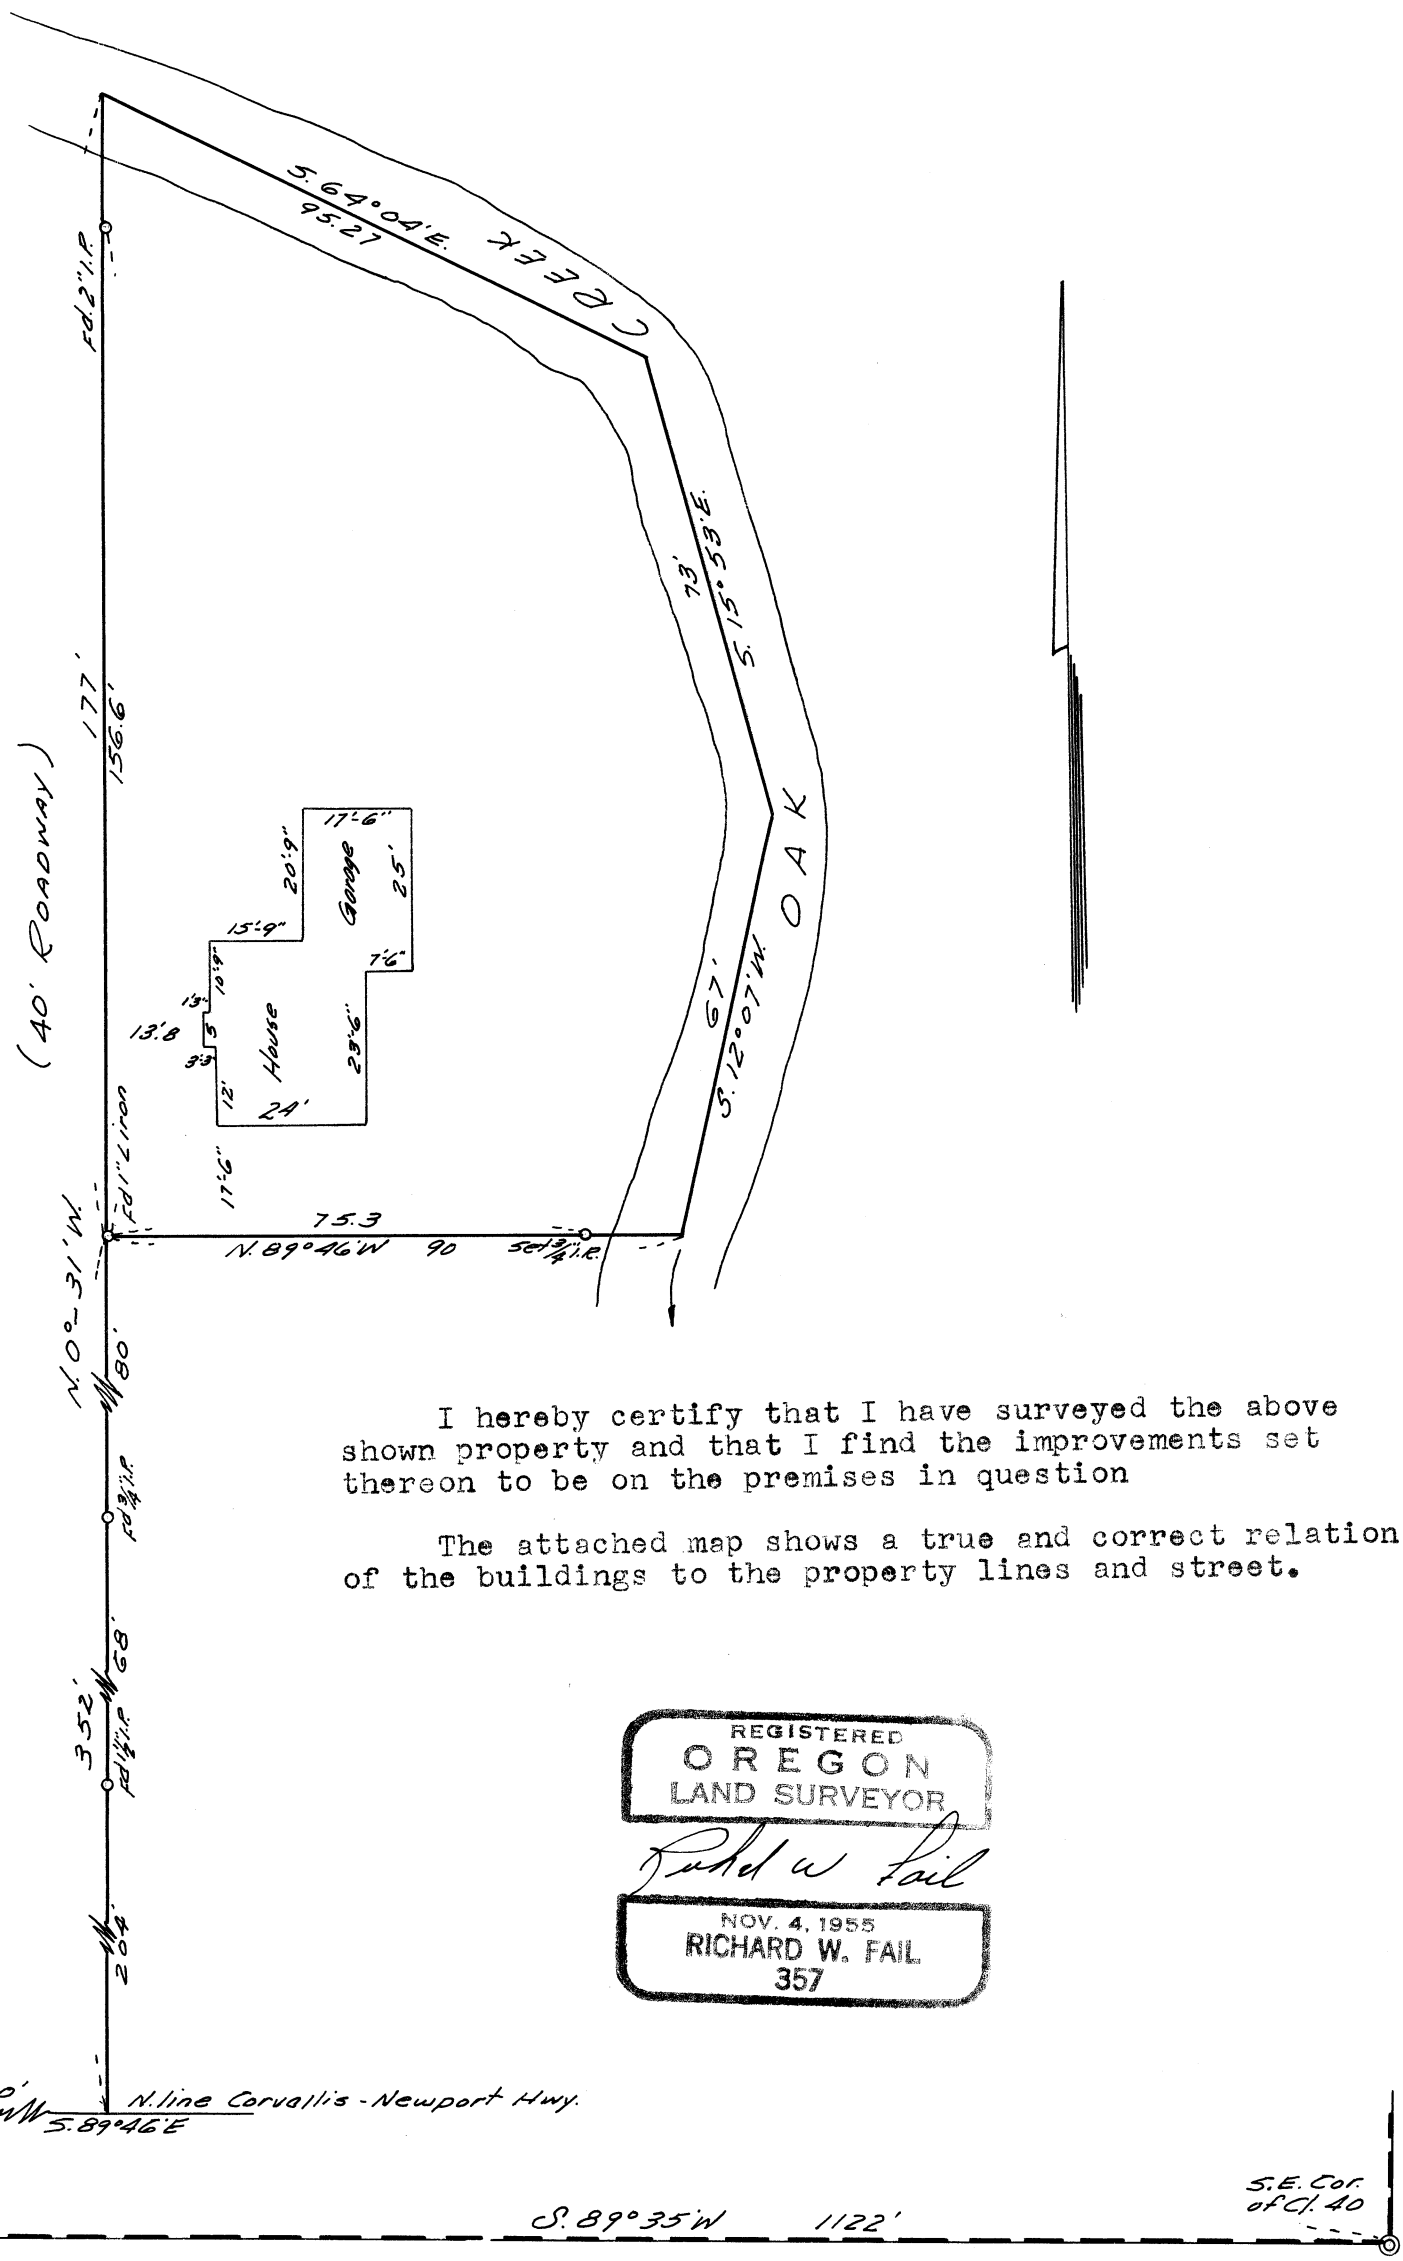

I hereby certify that I have surveyed the above shown property and that I find the improvements set thereon to be on the premises in question

The attached map shows a true and correct relation of the buildings to the property lines and street.

REGISTERED
OREGON
LAND SURVEYOR
Richard W Fail
NOV. 4, 1955
RICHARD W. FAIL
357