4096

4096

CS 4096

Record of Survey
for
KAY KOWALSKI
in the
Samuel F. Starr D.L.C. 49
N.E. 1/4 Sec. 21, T. 14S., R. 5W. W.M.
Benton County, Oregon
Scale 1"=200' June 16, 1965

4096

Parentheses denote information from C.S. Records

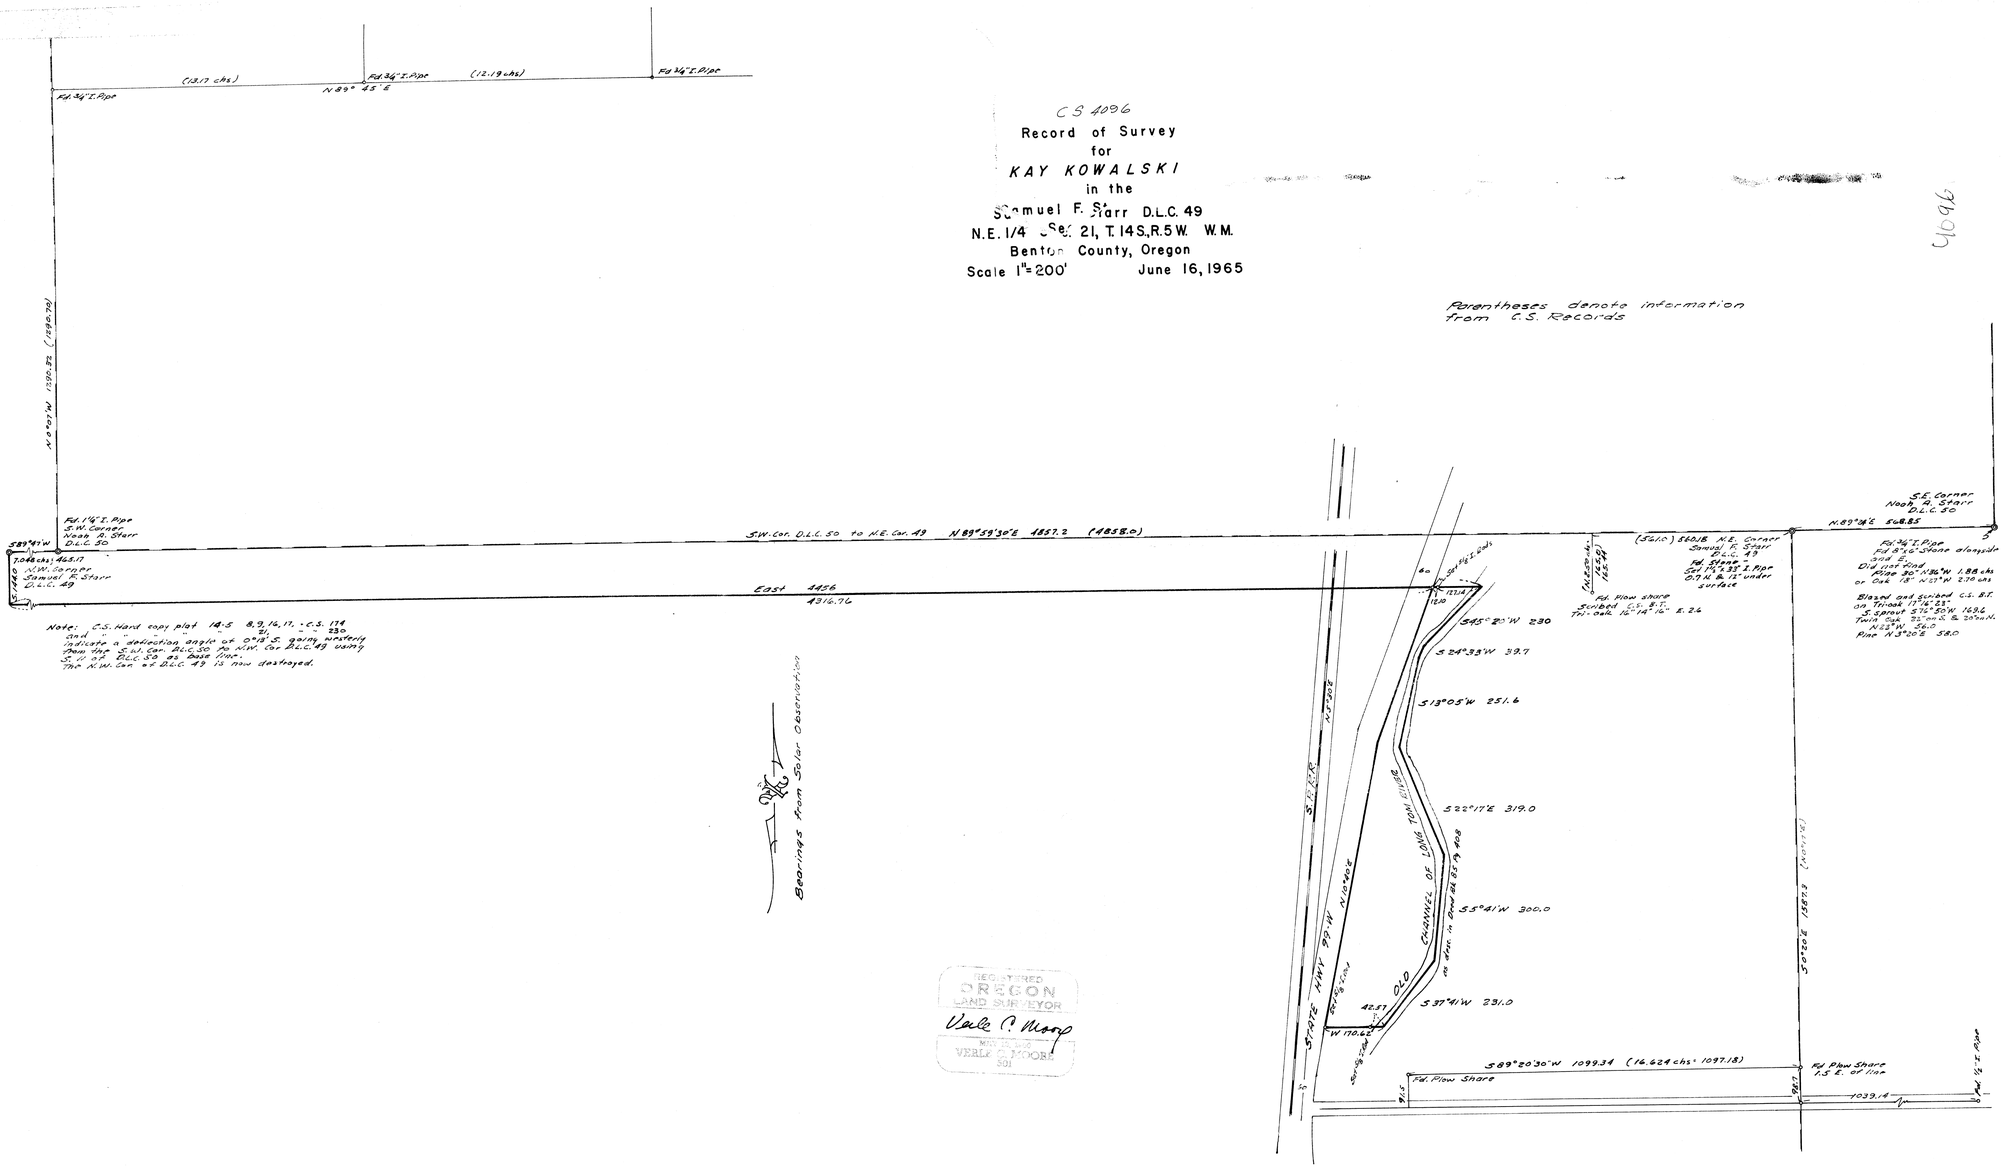

Bearings from Solar Observation

REGISTERED
OREGON
LAND SURVEYOR
Verle C. Moore
VERLE C. MOORE
501