CS 4166

SURVEY

FOR

VERNON L. BOWLBY

LOT 20

FIRST ADDITION TO CLOVERLAND VILLAGE

SECTION 27, T11S, R5W, W.M., BENTON COUNTY, OREGON

CITY OF CORVALLIS

SCALE 1" = 20'

OCTOBER, 1965

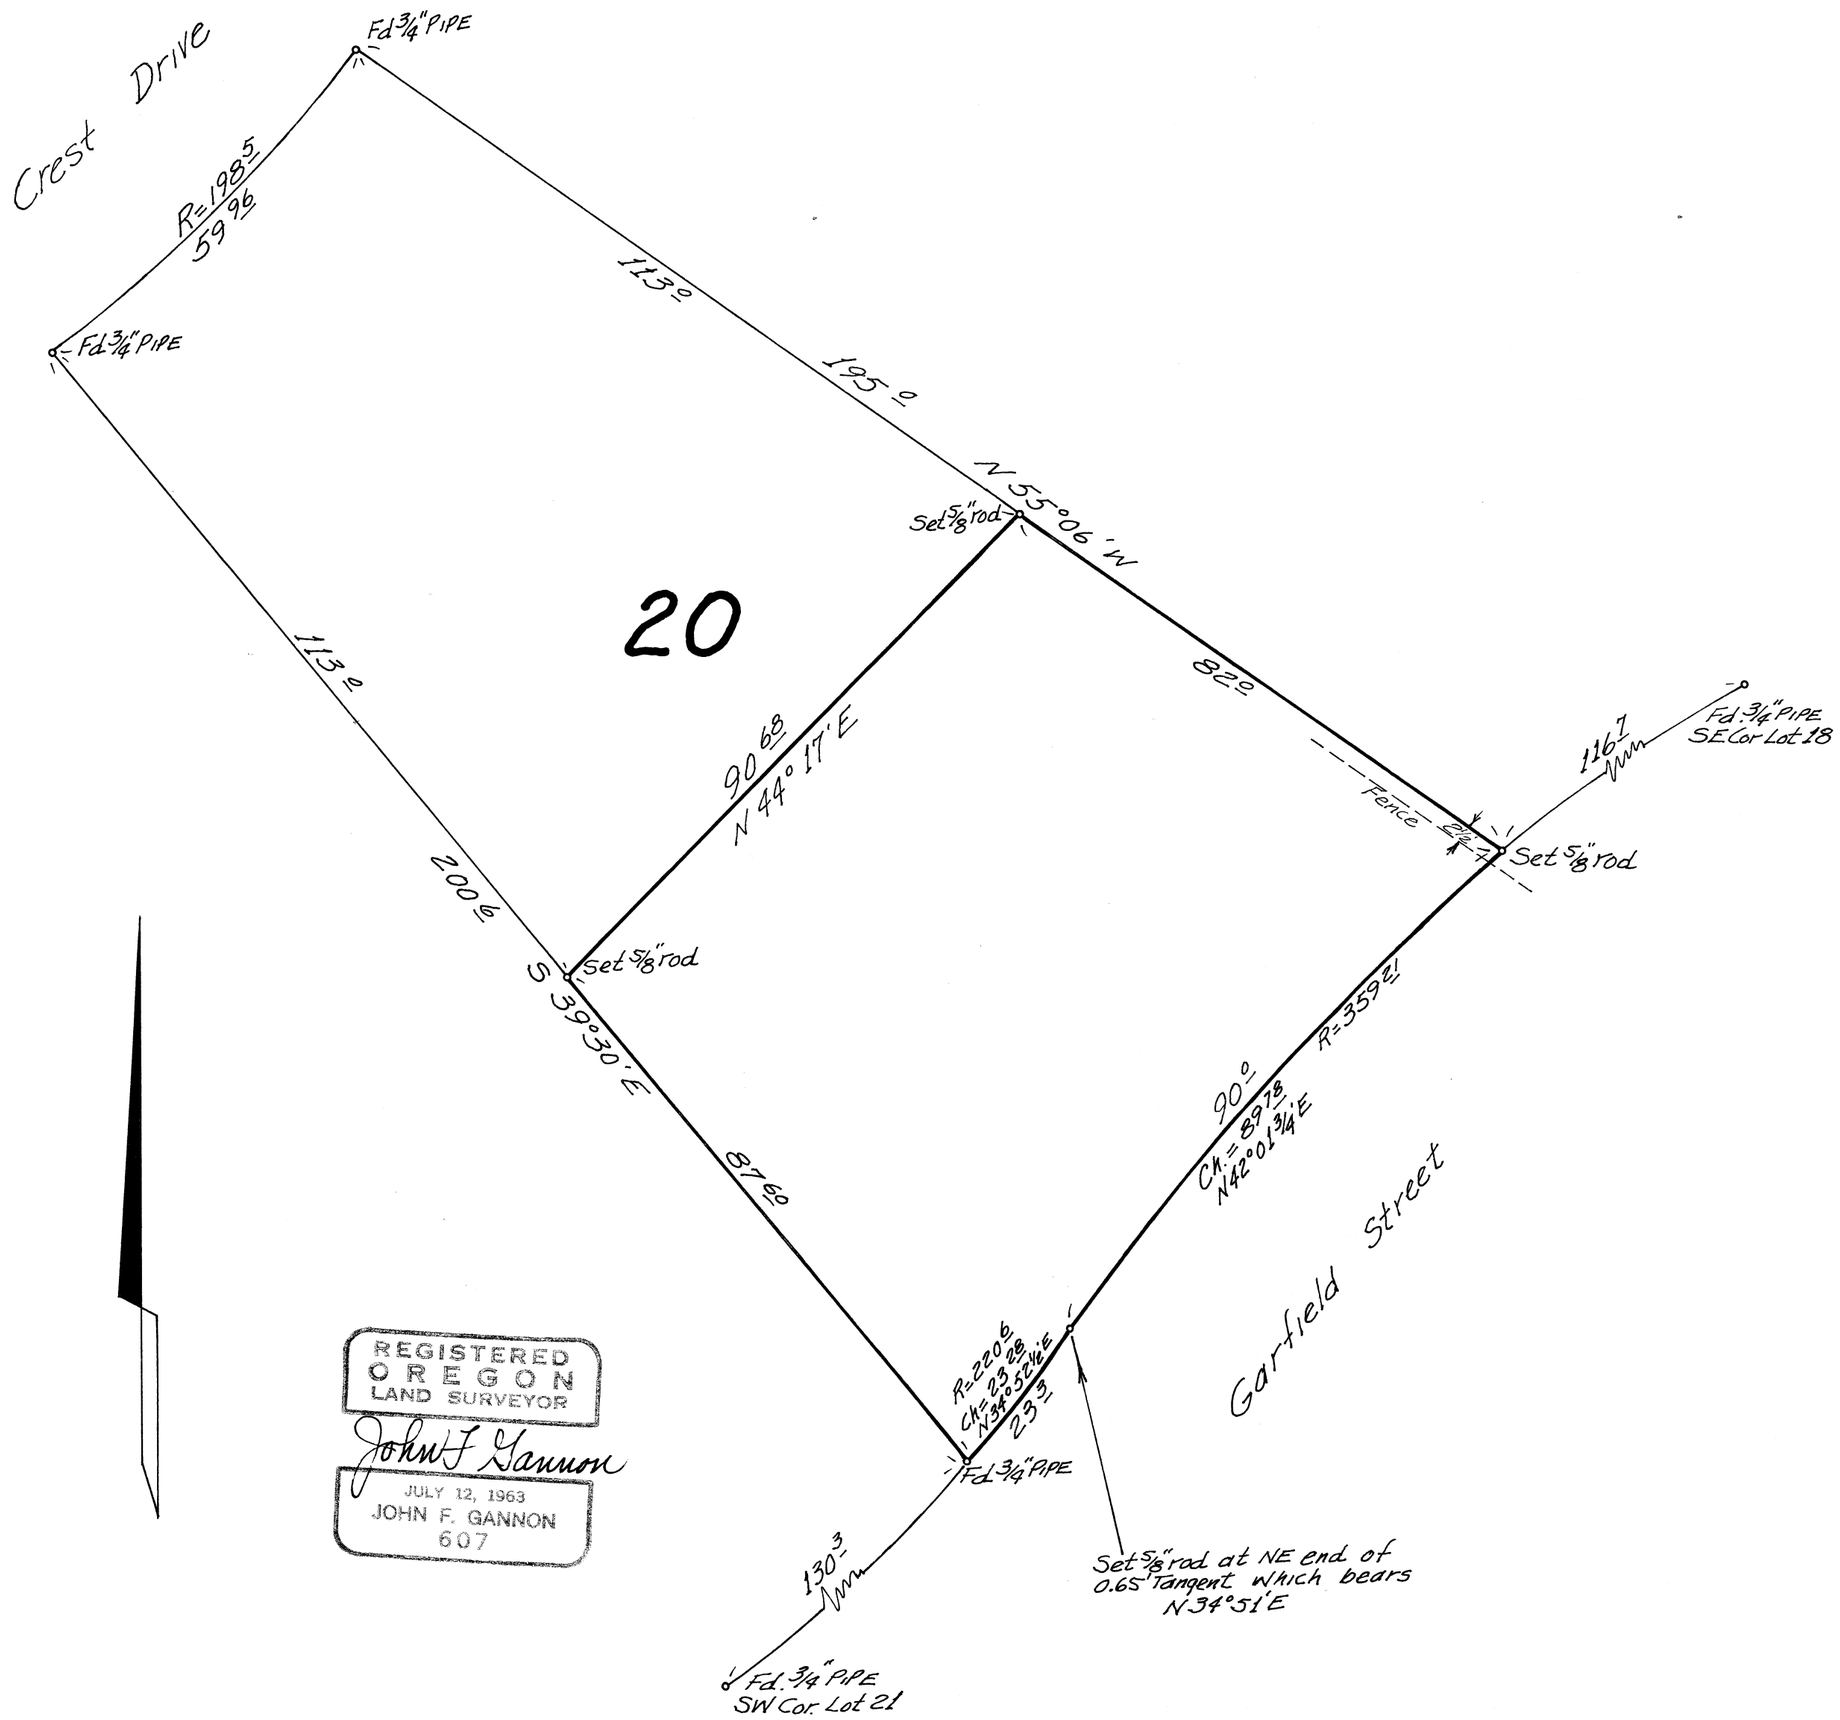

REGISTERED
OREGON
LAND SURVEYOR
John F Gannon
JULY 12, 1963
JOHN F. GANNON
607

4166