CS 4274

SURVEY FOR

JAMES R. HEALD
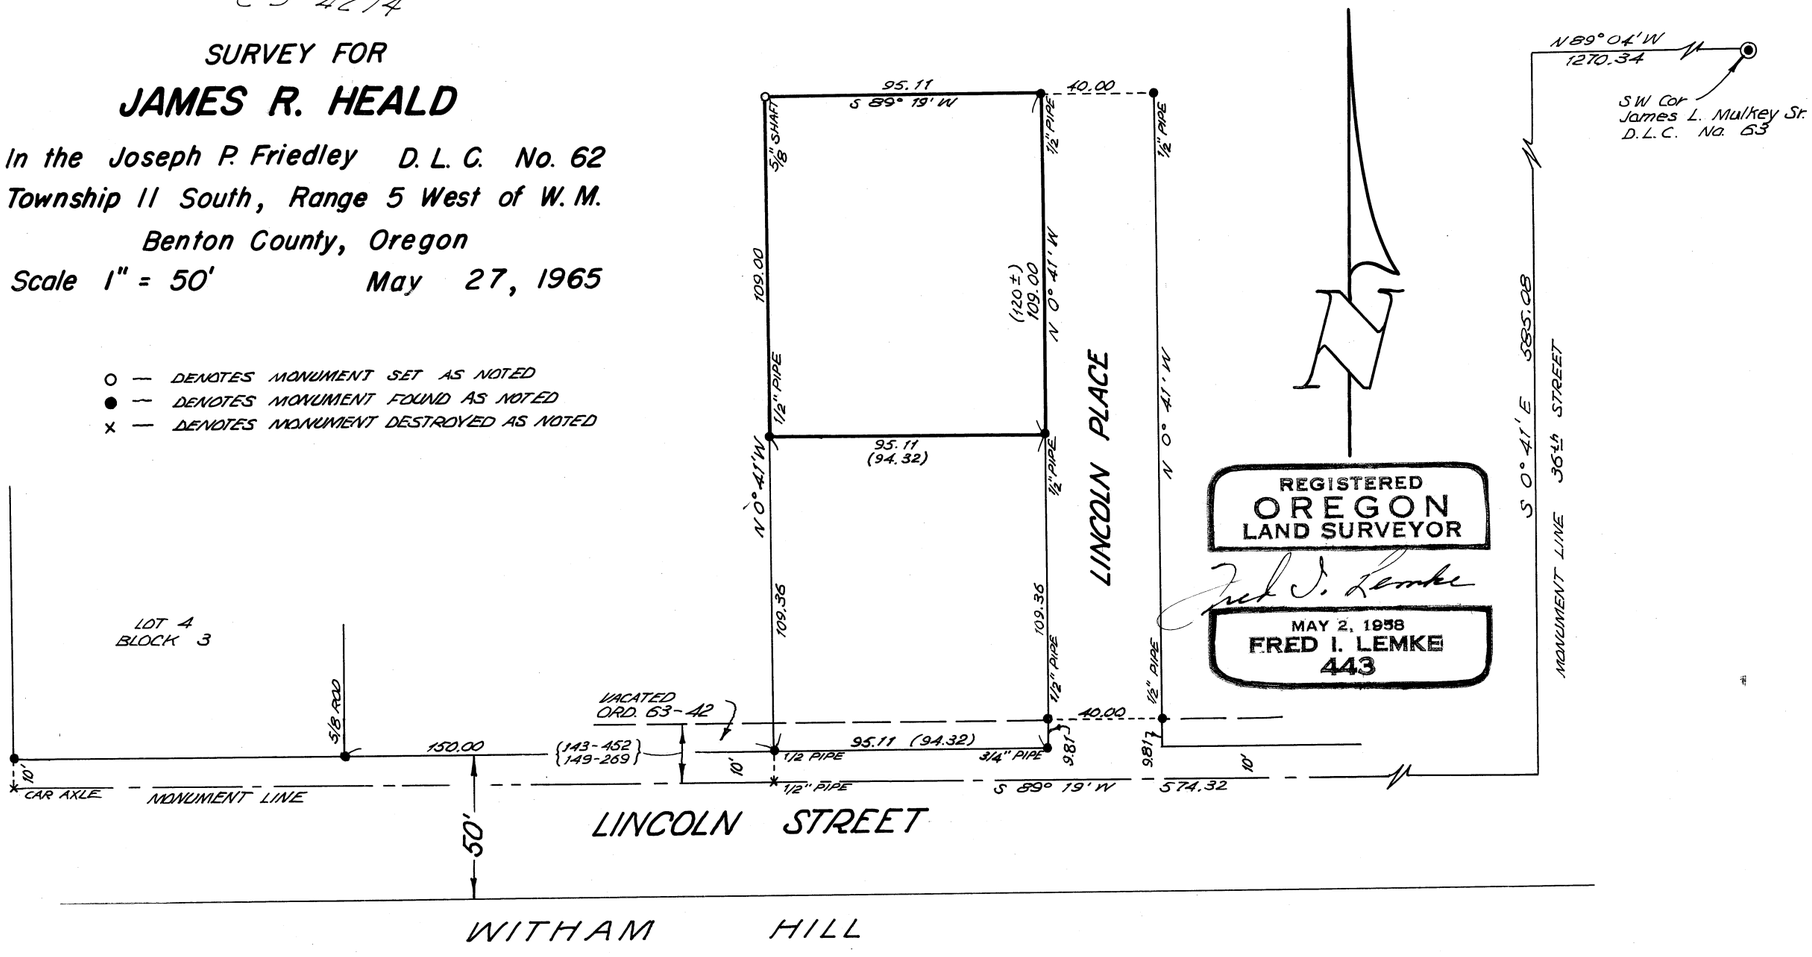
In the Joseph P. Friedley D. L. C. No. 62
Township 11 South, Range 5 West of W. M.
Benton County, Oregon
Scale 1" = 50' May 27, 1965