4417

SURVEY FOR

PAUL HANRAHAN

A PORTION OF LOT 16
F.L.LILLY TRACTS ALL IN
JOSEPH C. ALEXANDER D.L.C 46
SECTION 11 T.12 S.,R.5 W.,W.M.

SCALE: 1"=40' DATE: 6-15-67
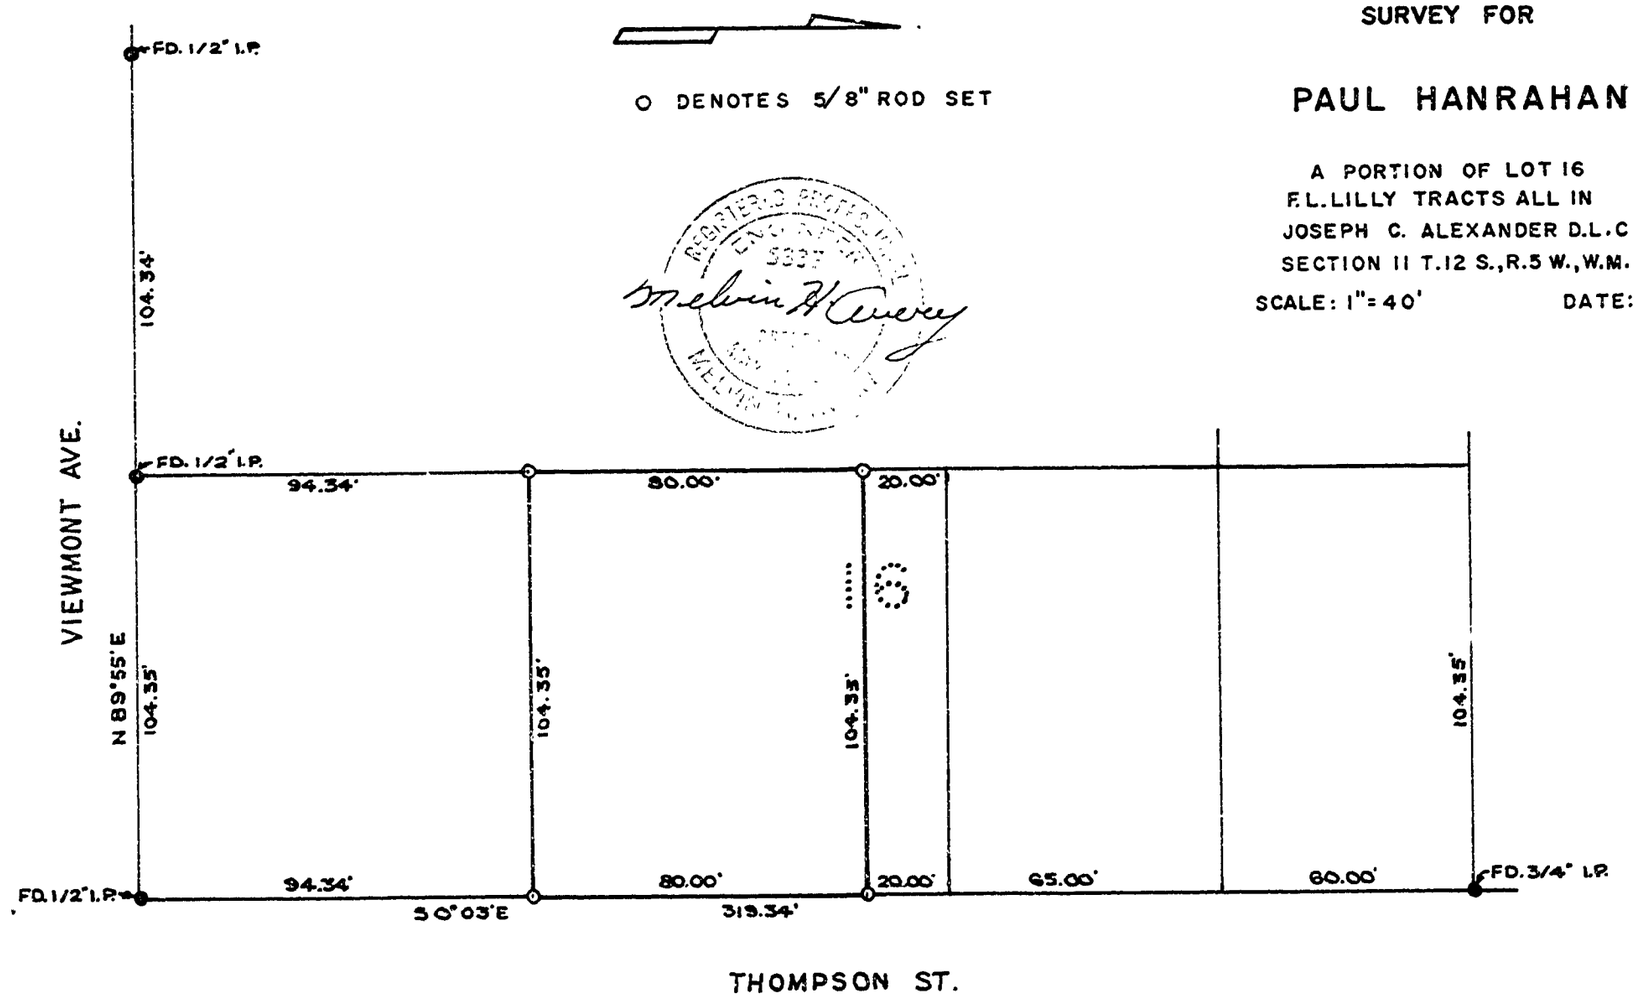
O DENOTES 5/8" ROD SET