4426

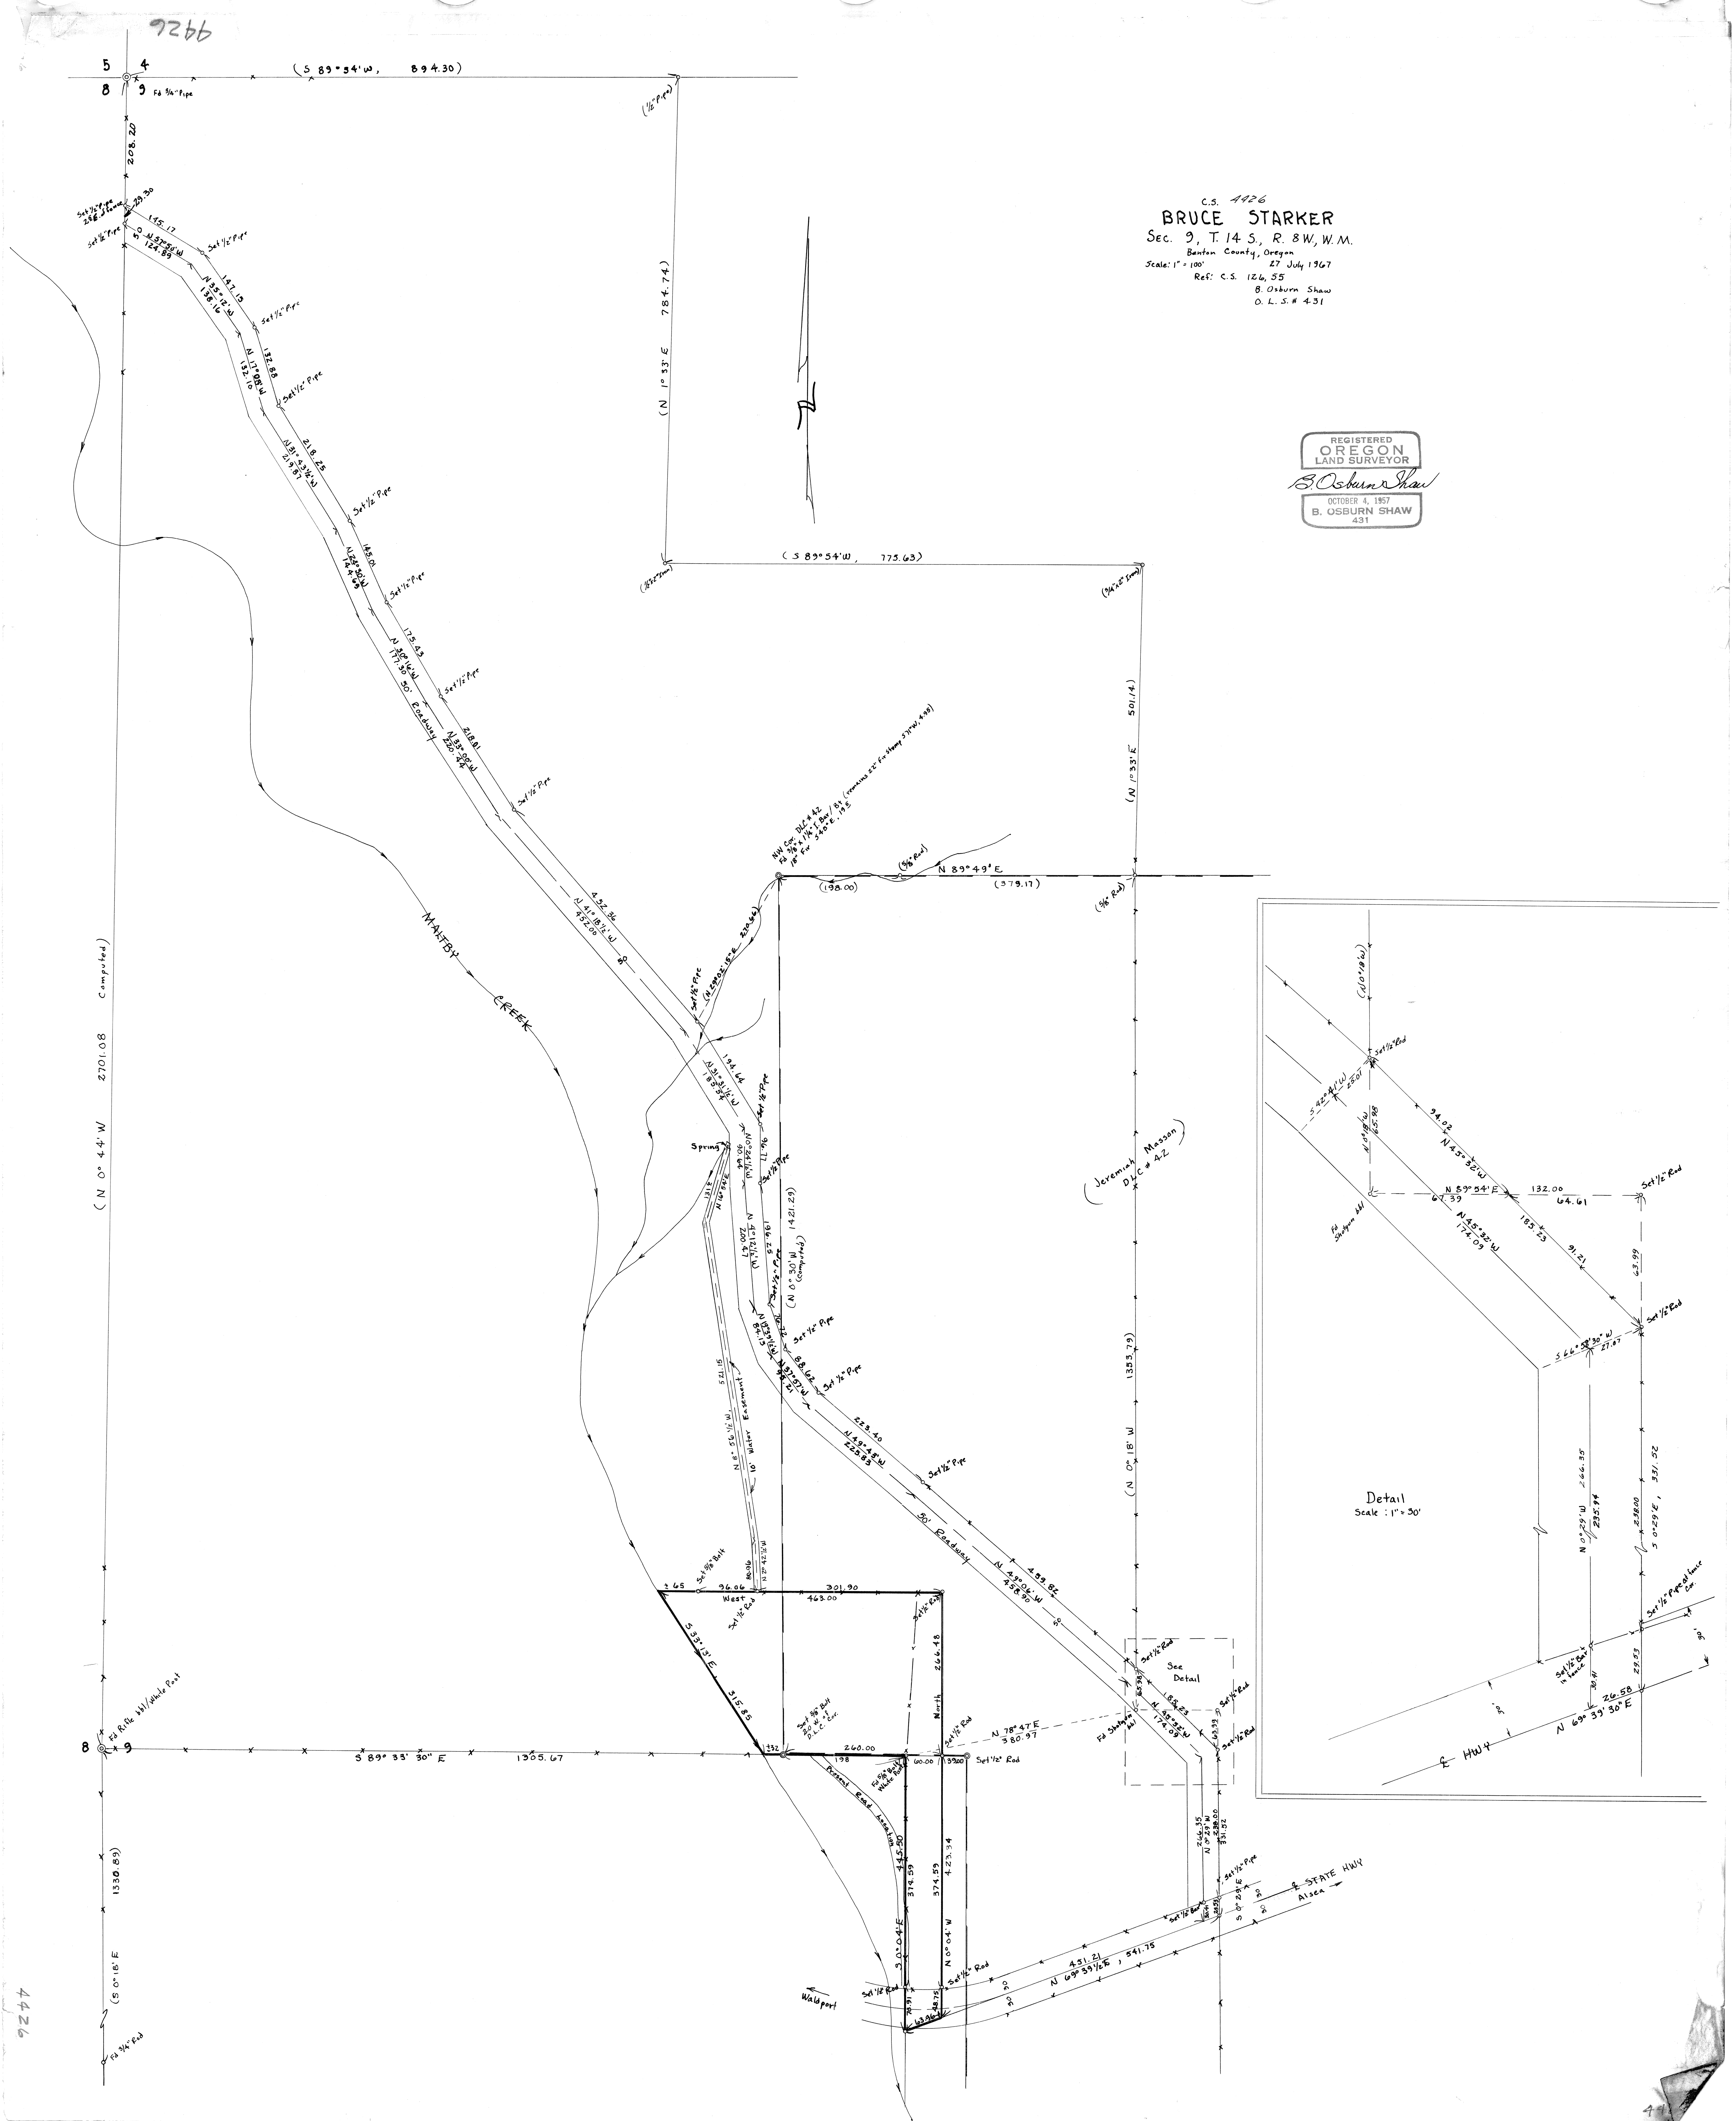
C.S. 4426
BRUCE STARKER
Sec. 9, T. 14 S., R. 8W., W.M.
Benton County, Oregon
Scale: 1" = 100'
27 July 1967
Ref: C.S. 126, 55
B. Osburn Shaw
O.L.S. # 431
REGISTERED
OREGON
LAND SURVEYOR
B. Osburn Shaw
OCTOBER 4, 1957
B. OSBURN SHAW
431
(S 89°54'W, 894.30)
Fd 3/4" Pipe
208.20
(N 1°33'E 784.74)
(S 89°54'W, 775.63)
(1/2" Pipe)
(1/2"x2" Iron)
(3/4"x2" Iron)
(N 1°33'E 501.14)
Set 1/2" Pipe
N 57°50'W 124.89
145.17
N 35°12'W 138.16
147.15
N 17°08'W 132.10
132.88
N 31°43 1/2'W 219.87
218.25
N 24°30'W 144.69
145.01
N 30°16'W 177.30
175.43
50' Roadway
N 33°00'W 220.44
218.01
N 41°18 1/2'W 452.00
452.36
MALTBY CREEK
NW Cor. DLC # 42
(198.00)
N 89°49'E
(379.17)
(5/8" Rod)
(N 0°44'W 2701.08 Computed)
Spring
10' Water Easement
N 8°56 1/2'W 521.15
(N 0°30'W 1421.29 (Computed))
N 49°48'W 225.83
223.40
N 49°06'W 458.90
459.82
(Jeremiah Masson DLC # 42)
(N 0°18'W 1353.79)
Set 5/8" Bolt
West
96.06
301.90
463.00
S 33°13'E 315.85
North 266.48
N 78°47'E 380.97
Fd Rifle bbl/White Post
S 89°33'30"E 1305.67
260.00
Present Road Location
Fd 5/8" Bolt White Post
Set 1/2" Rod
(S 0°18'E 1330.89)
Fd 3/4" Rod
S 0°04'E 445.50
374.59
N 0°04'W 423.34
Waldport
N 69°39 1/2'E 451.21, 541.75
℄ STATE HWY
Alsea
See Detail
Fd Shotgun bbl
Detail
Scale: 1" = 30'
S 42°41'W 23.01
N 0°18'W 65.98
N 45°32'W 94.02
N 89°54'E 132.00
67.39
64.61
N 45°32'W 174.09
185.23
91.21
63.99
S 66°58'30"W 27.07
N 0°29'W 266.35 235.94
238.00
S 0°29'E, 331.52
Set 1/2" Bar in fence
Set 1/2" Pipe at fence Cor.
30.41
29.53
26.58
N 69°39'30"E
℄ HWY
30'

4426