4697

4697

4697

SURVEY FOR
E.W. YORK

SCALE 1"=100' APRIL 20, 1968

IN

THE ABNER DRUMM D.L.C.

NO. 39 TOWNSHIP II SOUTH, RANGE 5 WEST OF W.M.

NO. 53 TOWNSHIP II SOUTH, RANGE 4 WEST OF W.M.

BENTON COUNTY, OREGON

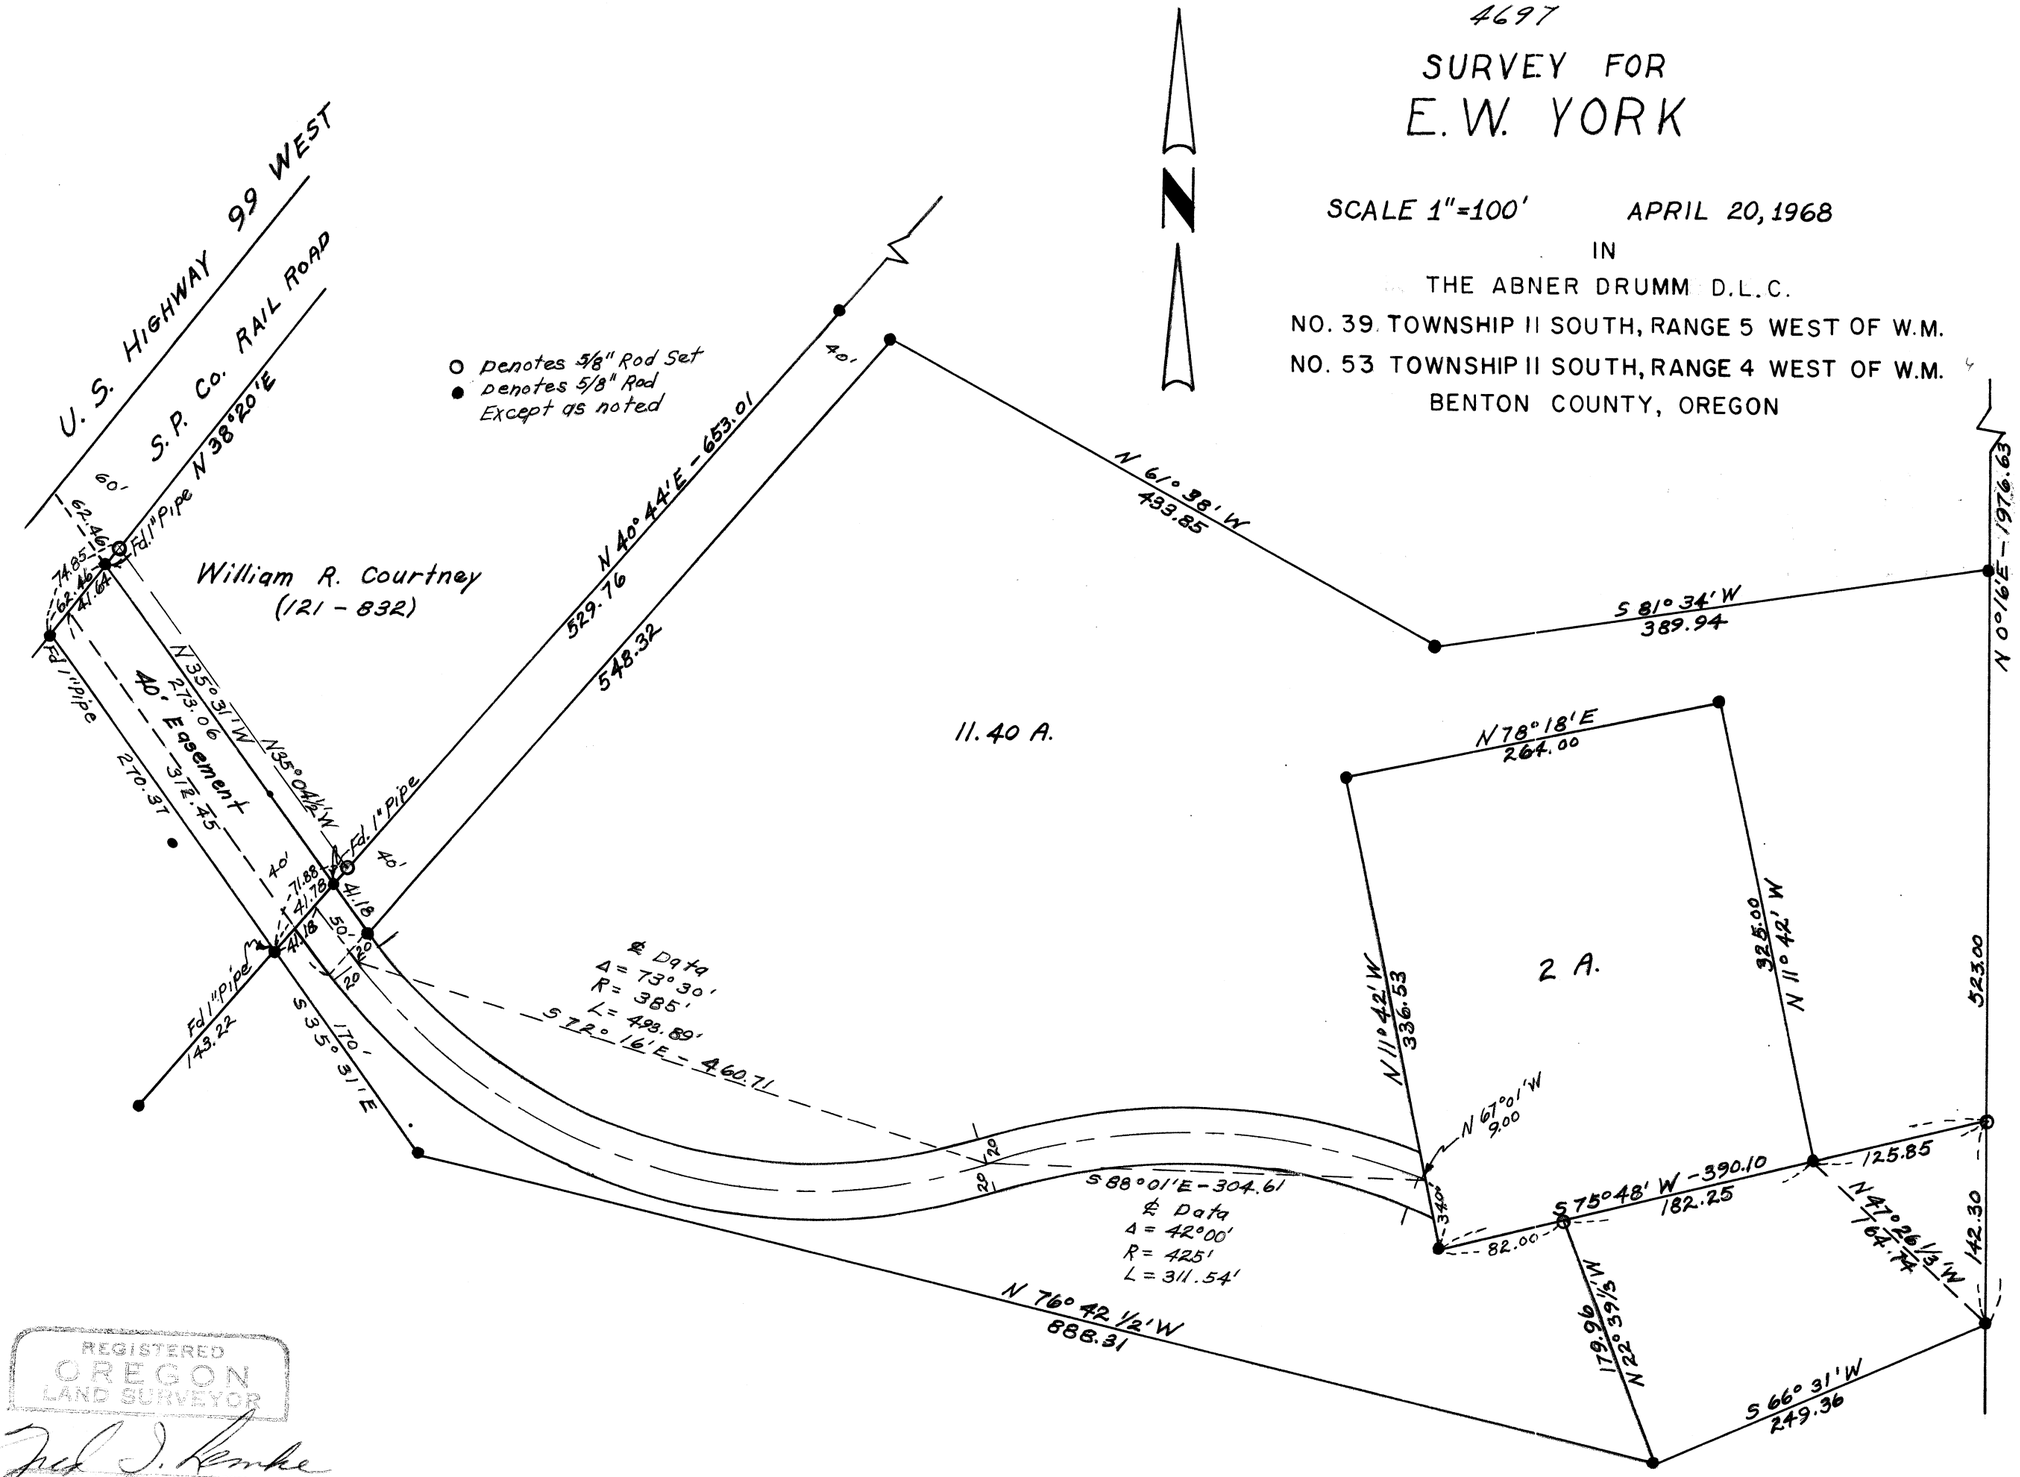

REGISTERED
OREGON
LAND SURVEYOR

Fred J. Lemke

MAY 2, 1968
FRED J. LEMKE
443