5221

G. STEINAUER

Lot 67, Block 18, PHILOMATH, BENTON CO. ORE.
Scale: 1" = 30' March 9, 1972

REGISTERED PROFESSIONAL LAND SURVEYOR
Martin L. Beyerlein
OREGON
NOVEMBER 5, 1948
MARTIN L. BEYERLEIN
247
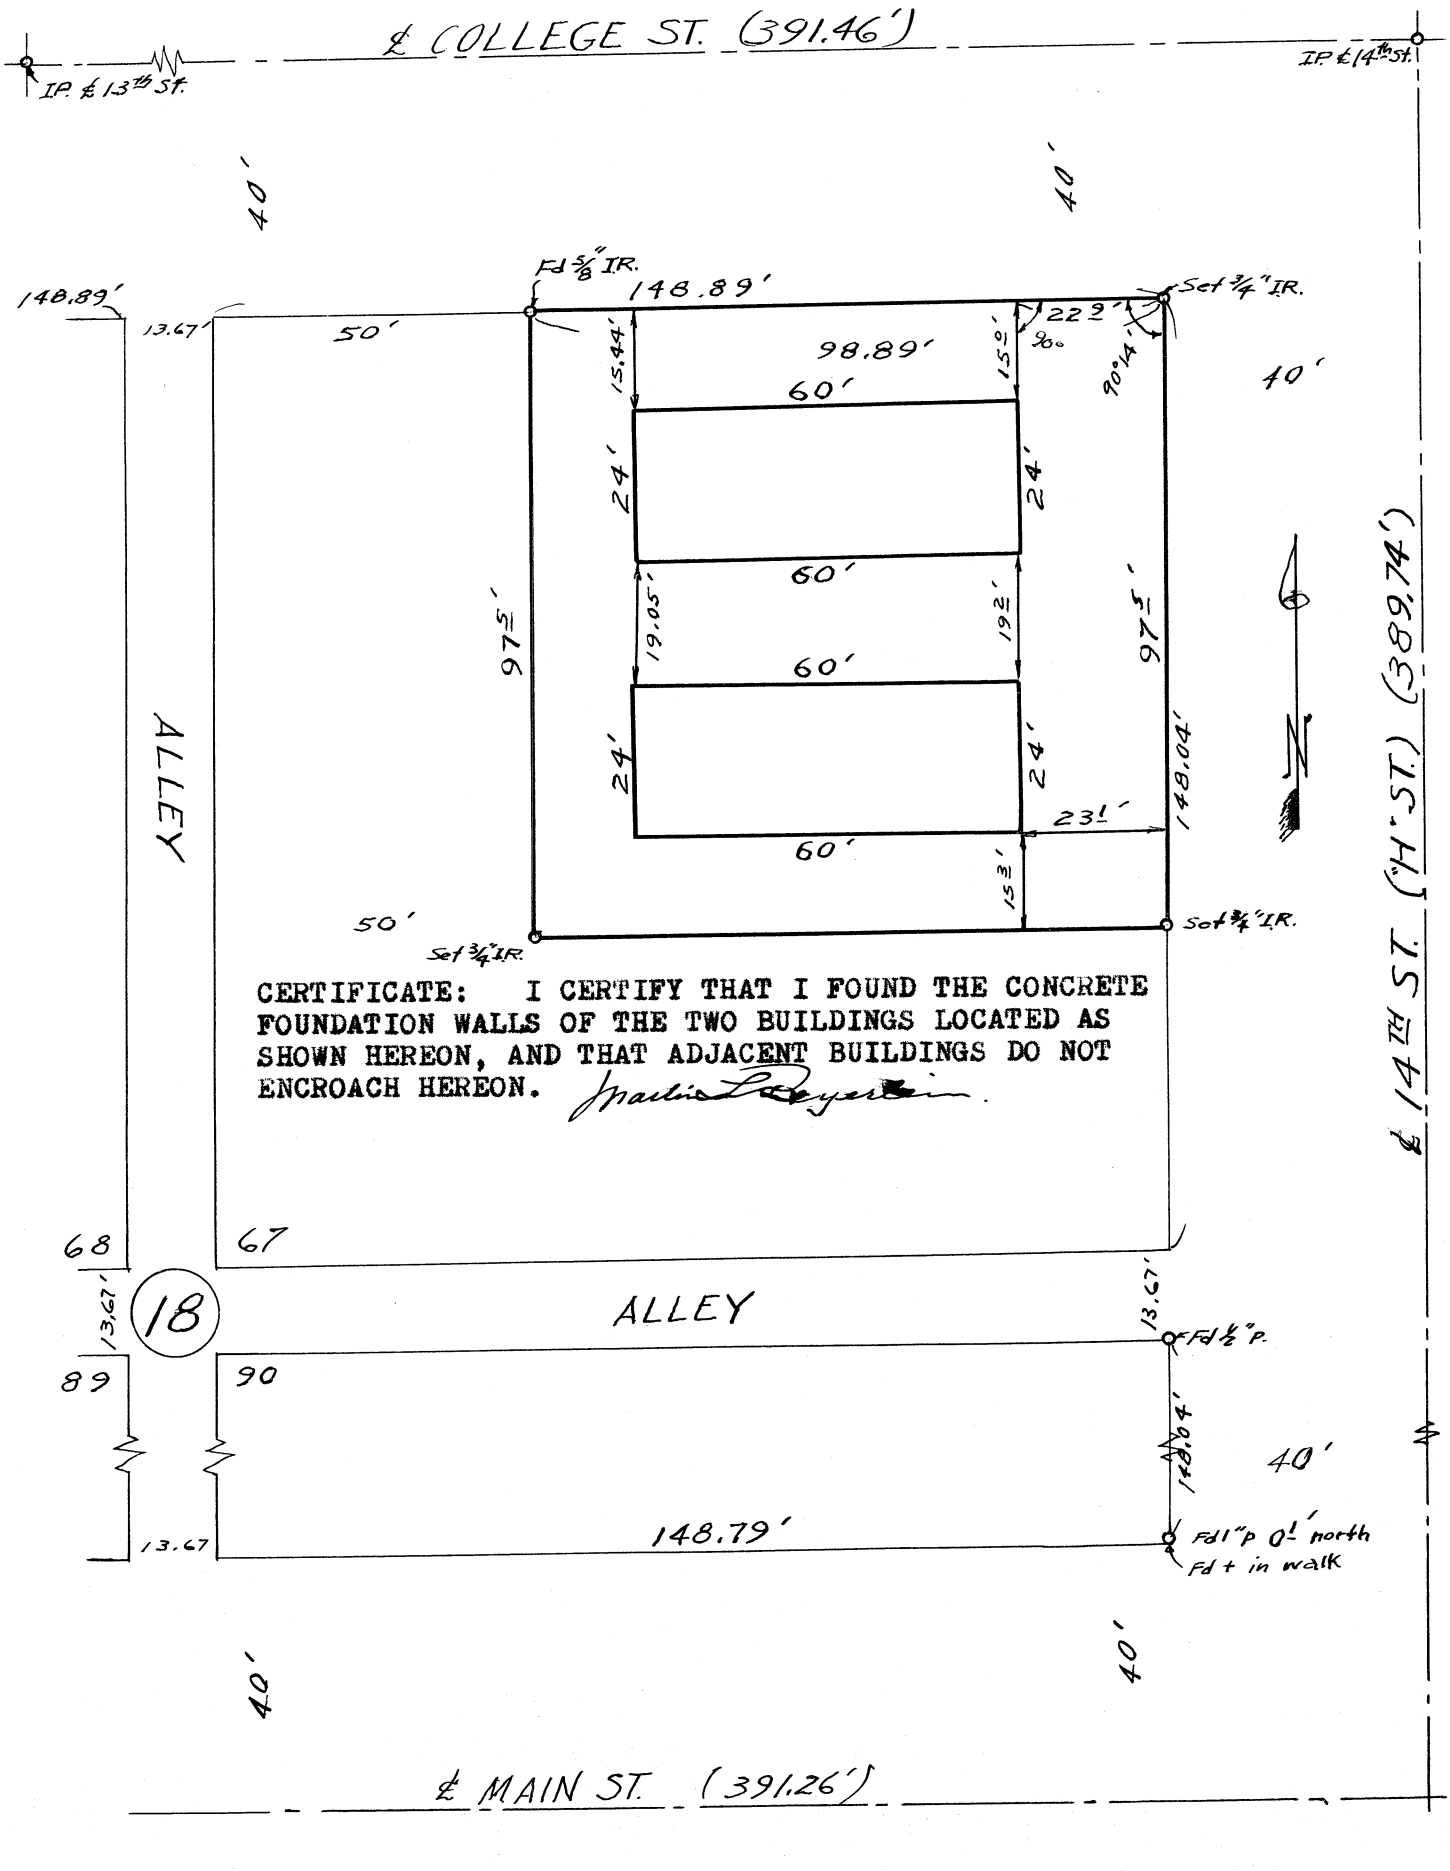
DESCRIPTION: THE NORTH 97.5 ft. OF LOT 67 BLOCK 18 OF THE CITY OF PHILOMATH, BENTON COUNTY, OREGON, EXCEPTING THE WEST 50 ft. THEREOF.