5229

E. HOWARD

SEC. 2, T. 12 S., R. 6 W., W.M.

Scale: 1" = 3 ch. = 198 ft. March 28, 1972

REGISTERED PROFESSIONAL LAND SURVEYOR
OREGON
NOVEMBER 7, 1969
MARTIN L. PETERLEIN
227

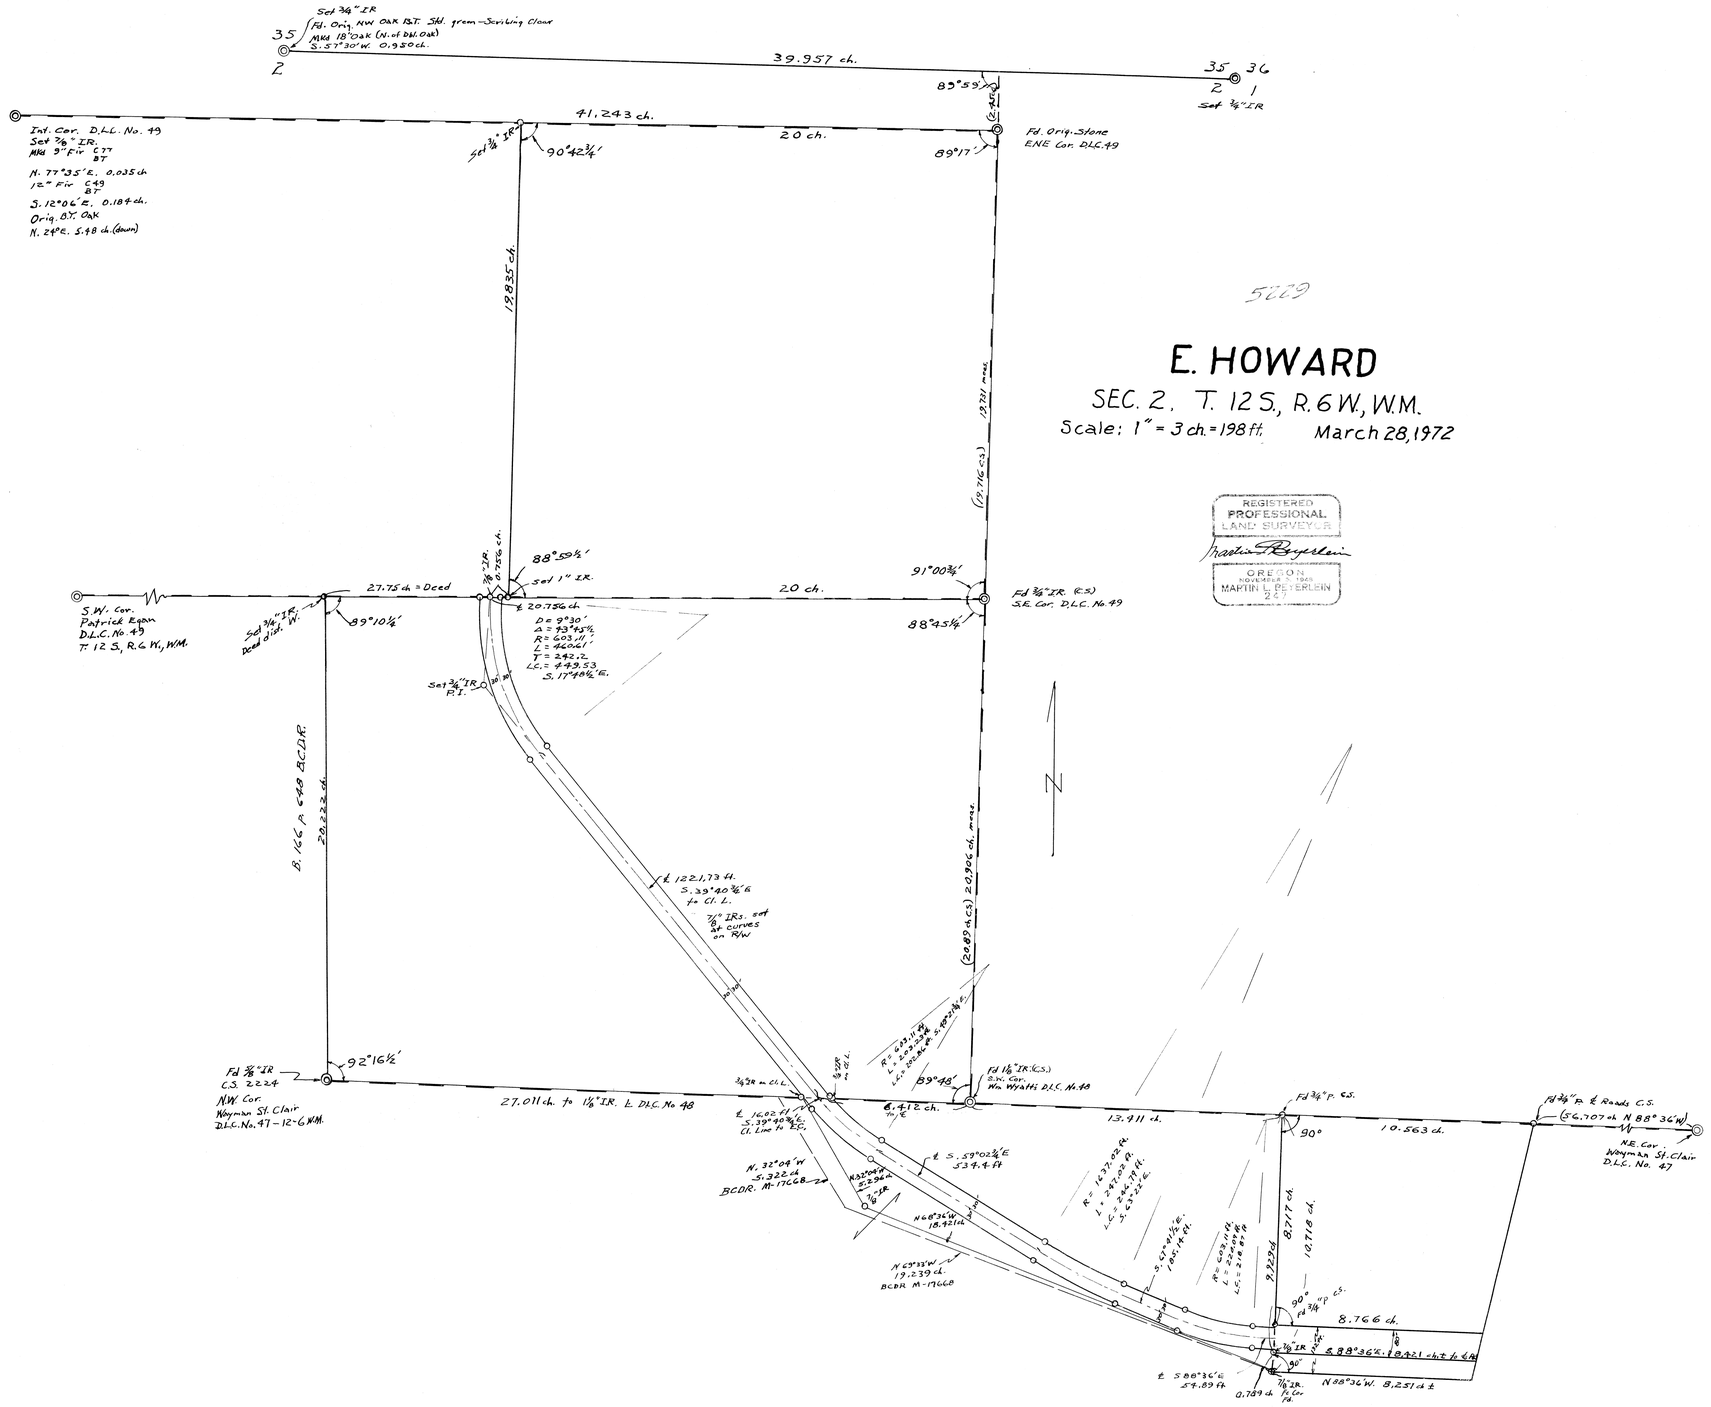

5229