5353

CITIZENS VALLEY BANK

NE 1/4, SECTION 23, T. 10 S., R. 4 W., W.M.
Benton County, Oregon

Scale: 1" = 100'

November 29, 1972

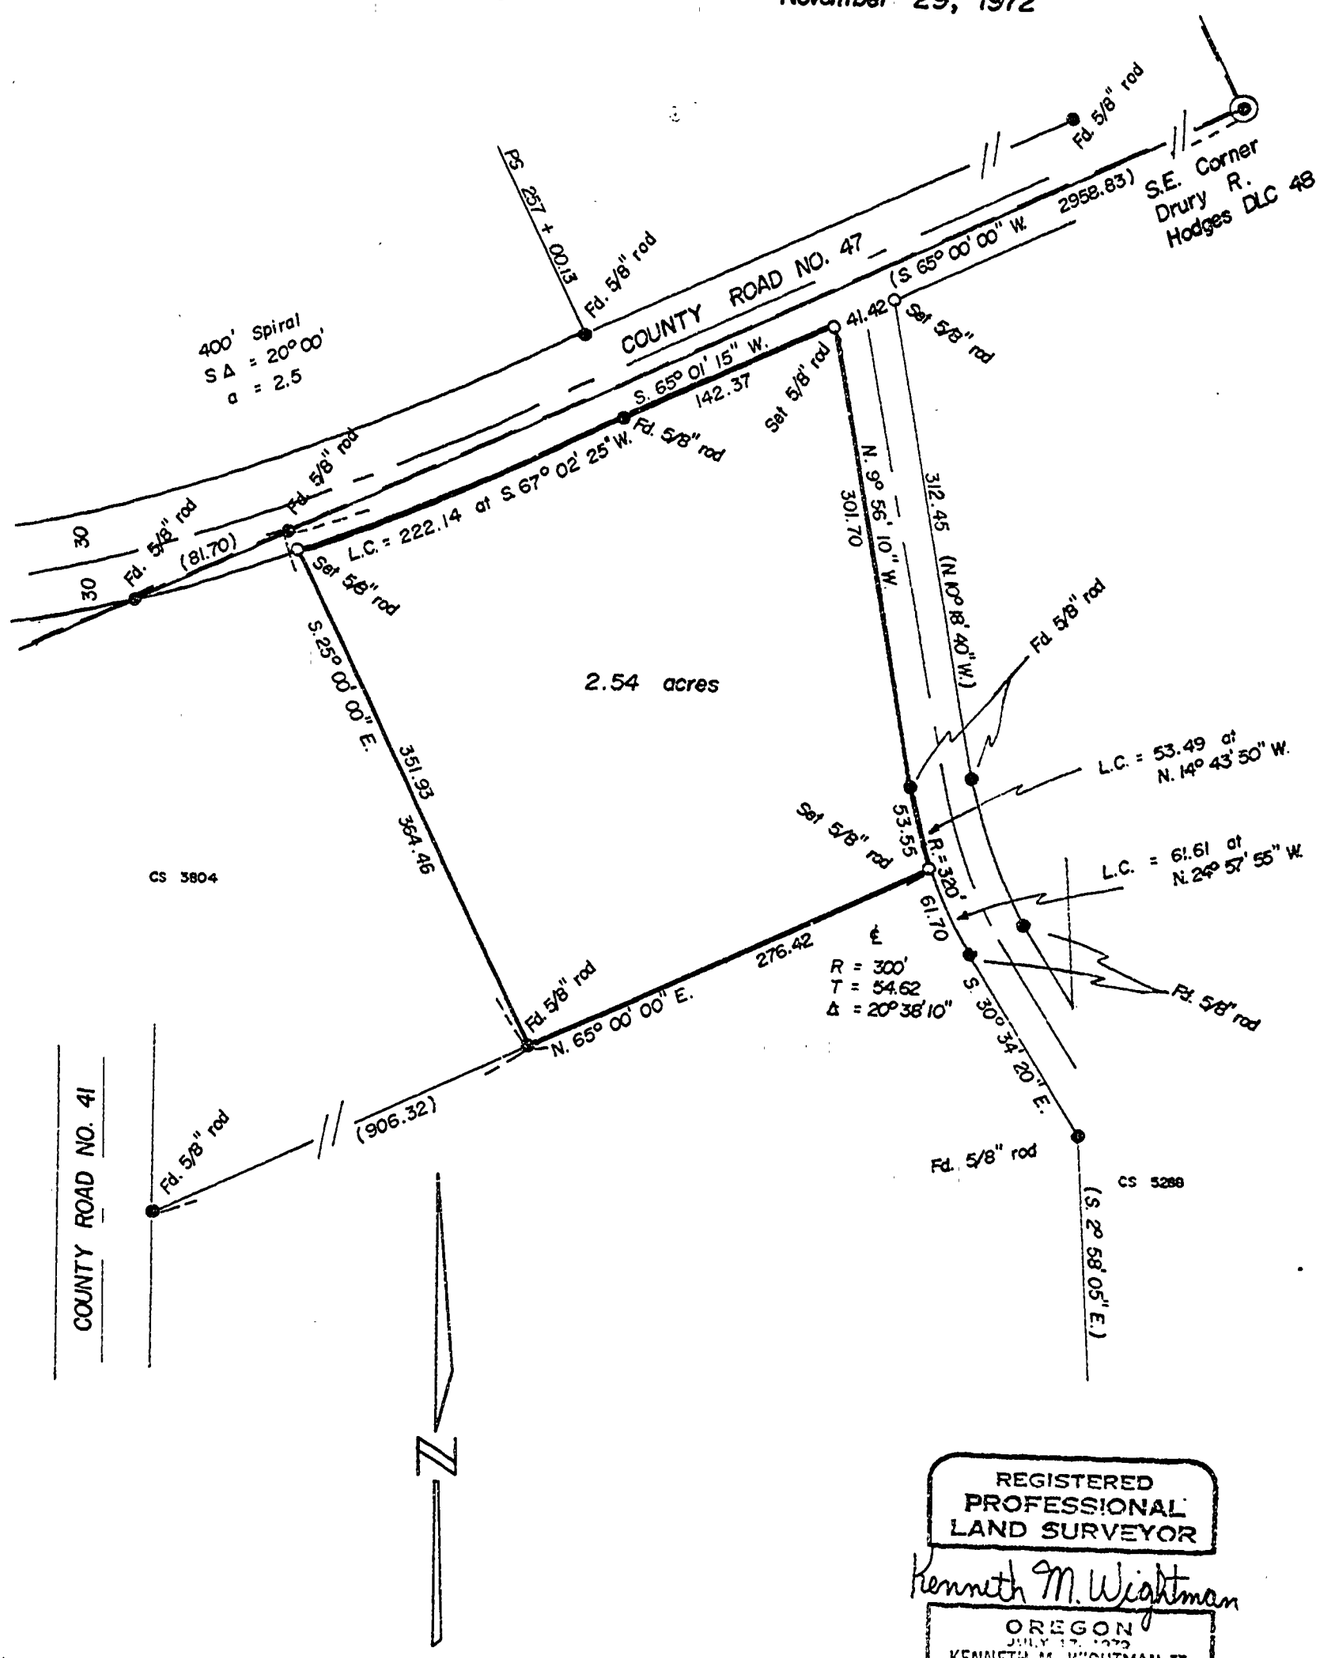

REGISTERED
PROFESSIONAL
LAND SURVEYOR
Kenneth M. Wightman
OREGON
JULY 17, 1979
KENNETH M. WIGHTMAN II
942

TIMBERLAND SERVICES, INC.
P.O. Box 663 - Albany, Ore. 97321
Phone: [illegible]