5379

Record of Survey
for
CARRIAGE REALTY
in the
Rawie-House Addition
Benton County, Oregon
Scale: 1" = 50' November 22, 1972

Parentheses indicate information
from County Survey records or deeds.

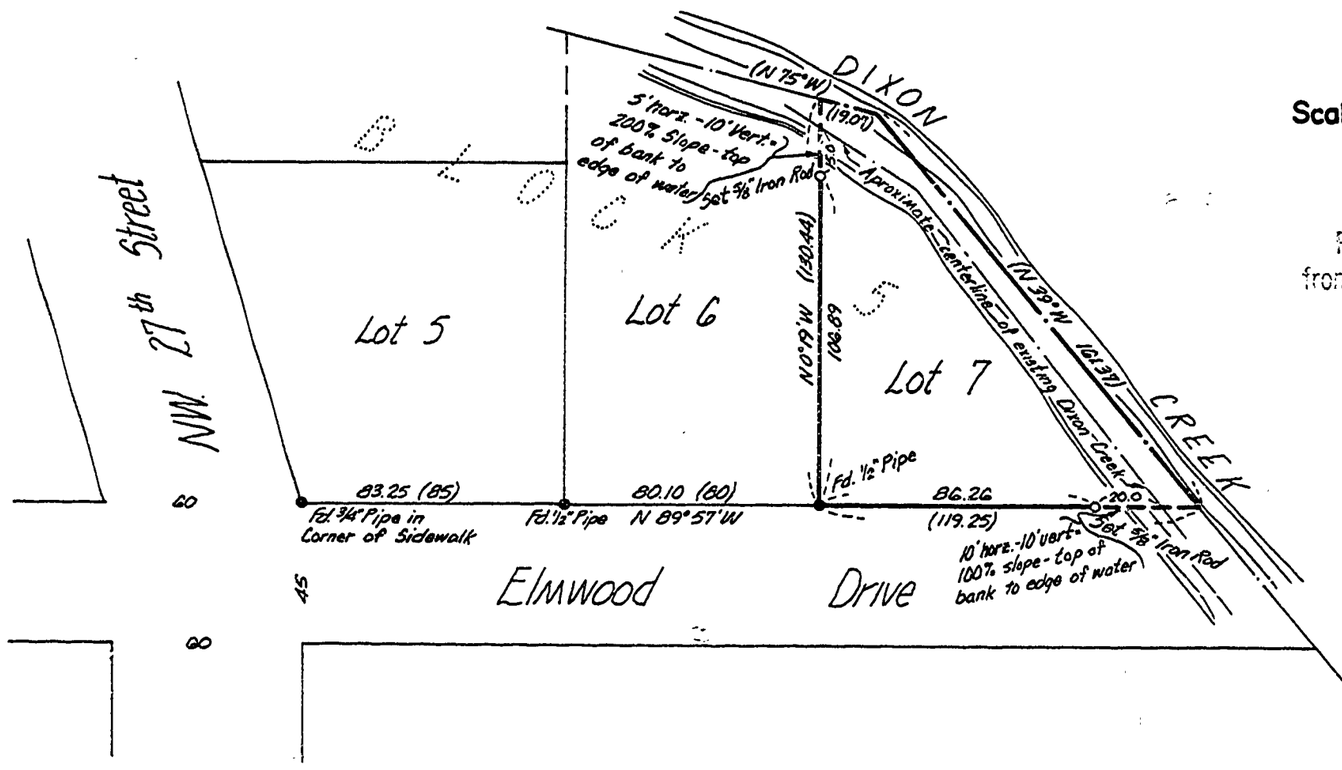

REGISTERED
PROFESSIONAL
LAND SURVEYOR

Verle C. Moore

OREGON
MAY 13, 1966
VERLE C. MOORE
501