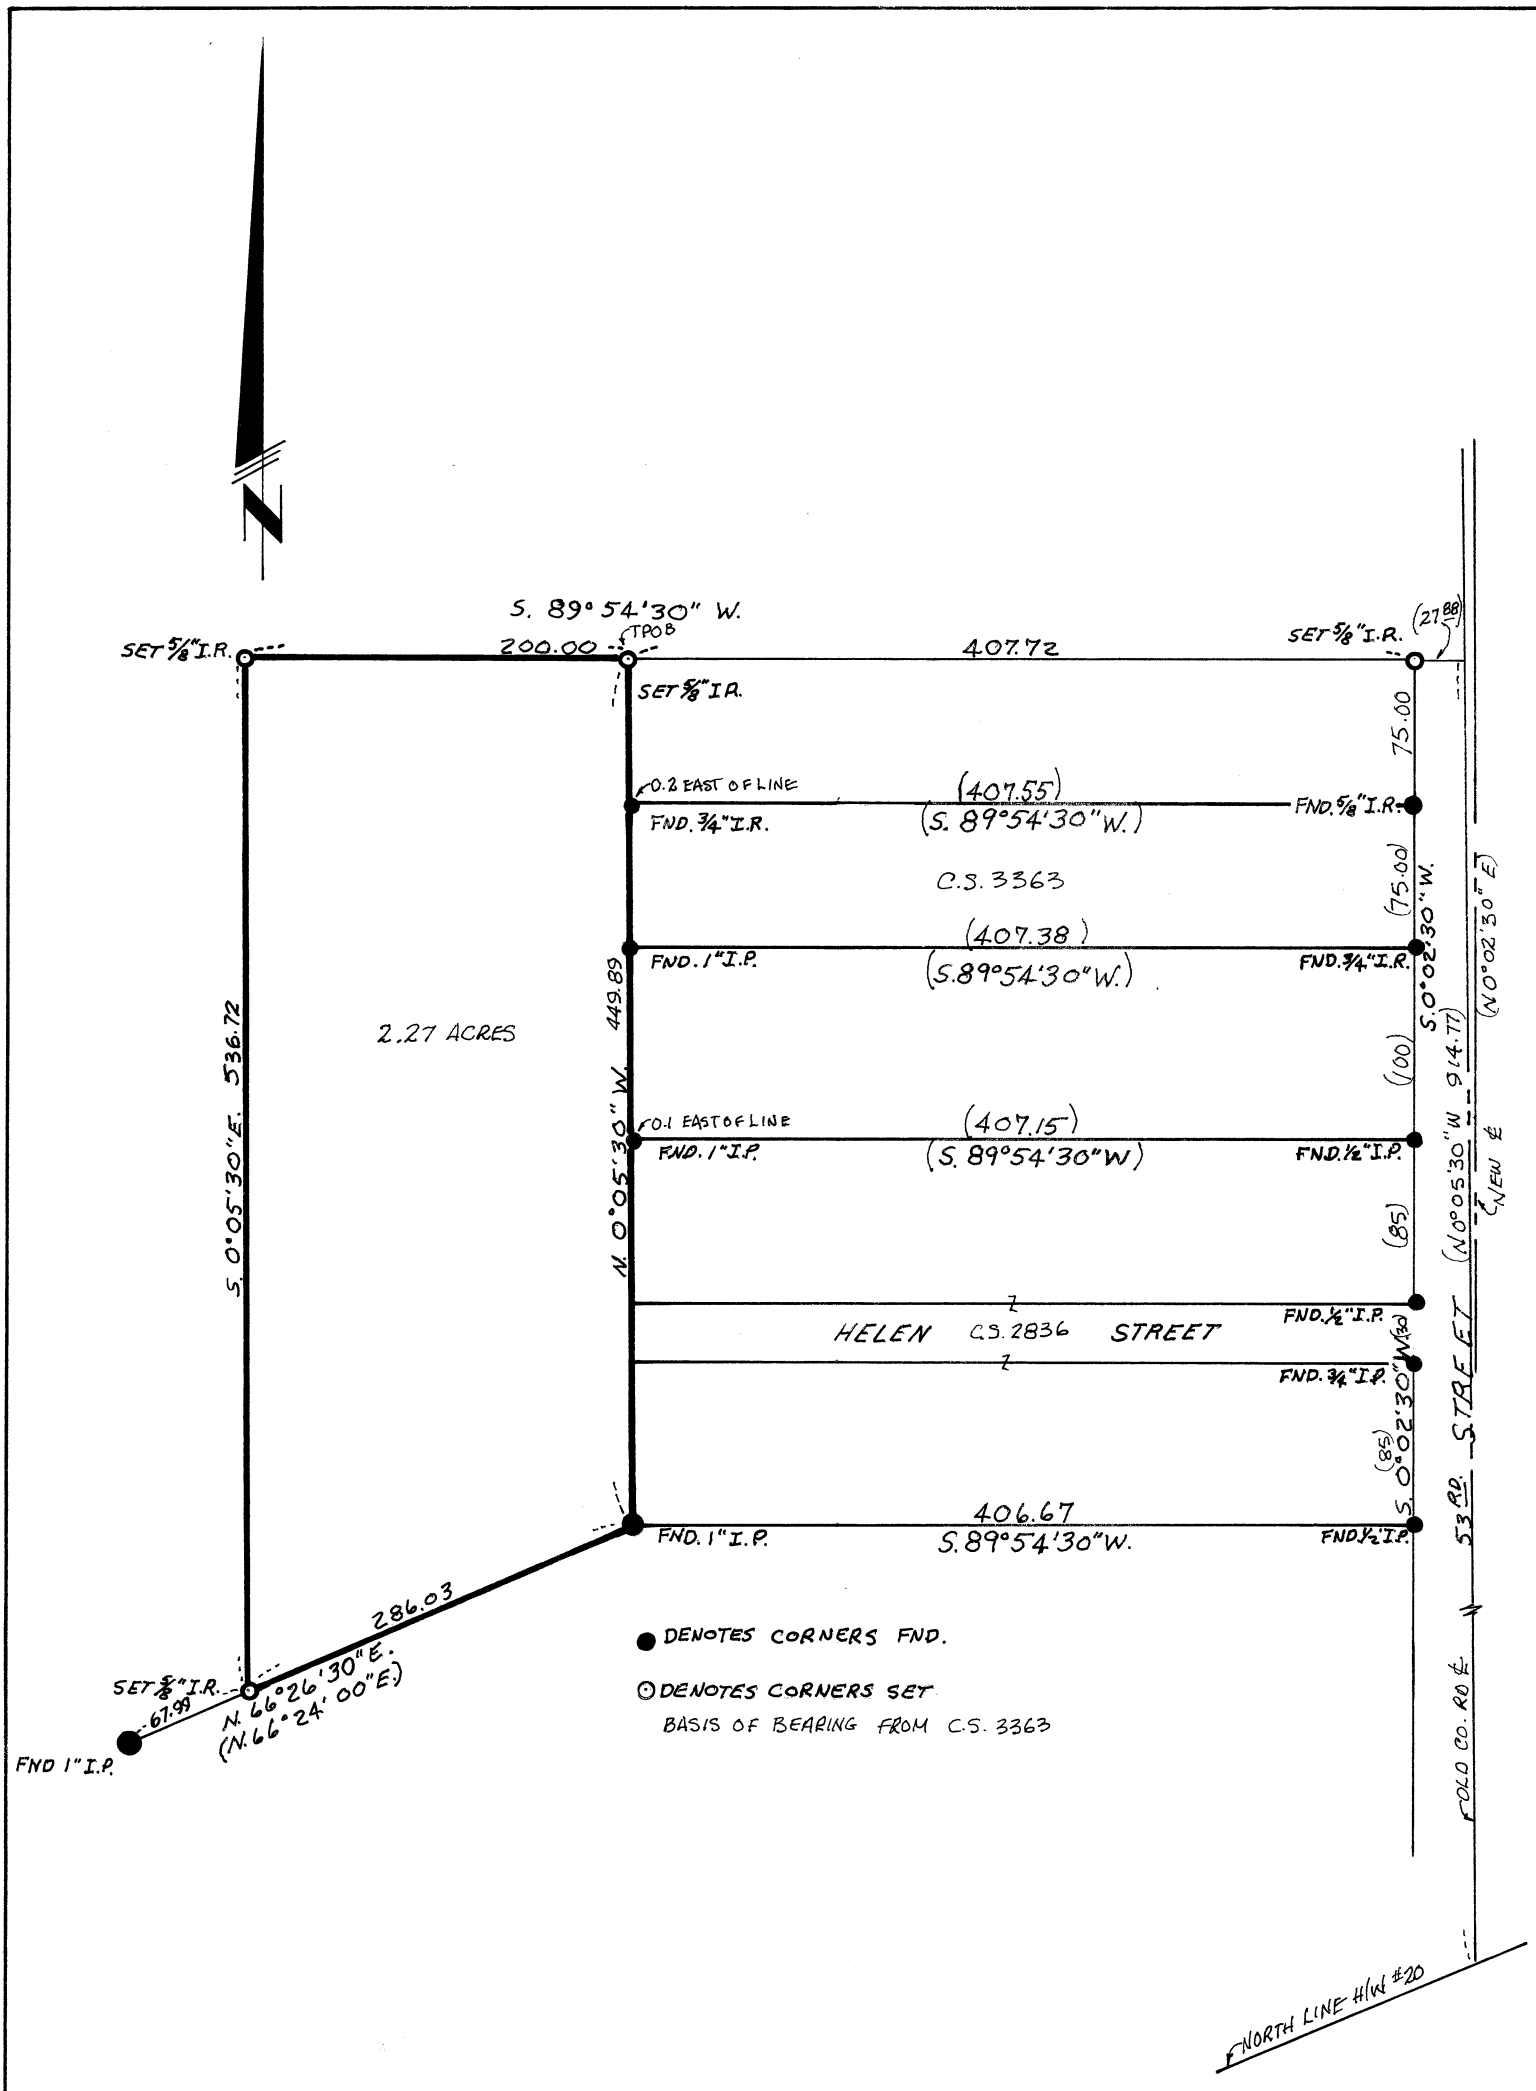

05769

SURVEY FOR JACK JOYCE

PORTION OF THE SW 1/4 SECTION 5, T12S, R5W
W.M. IN THE A.G. HOVEY DLC #43
BENTON COUNTY OREGON

McCULLOUGH, BRYANT & ASSOCIATES
CORVALLIS, OREGON

DRAWN BY	DATE	SCALE	BOOK #	DRAWING #
A.K.C.	10/14/74	1" = 100'	156	14-9

REGISTERED PROFESSIONAL LAND SURVEYOR
OREGON
JULY 10, 1974
TOM O. McCULLOUGH