5816

5814

0316

RECORD OF SURVEY

FOR *BUILDER'S SUPPLY CO.*

IN Sections 20 & 29, Township 11 South, Range 4 West, W. M.
Benton County, Oregon January, 1975
Scale: 1" = 100'
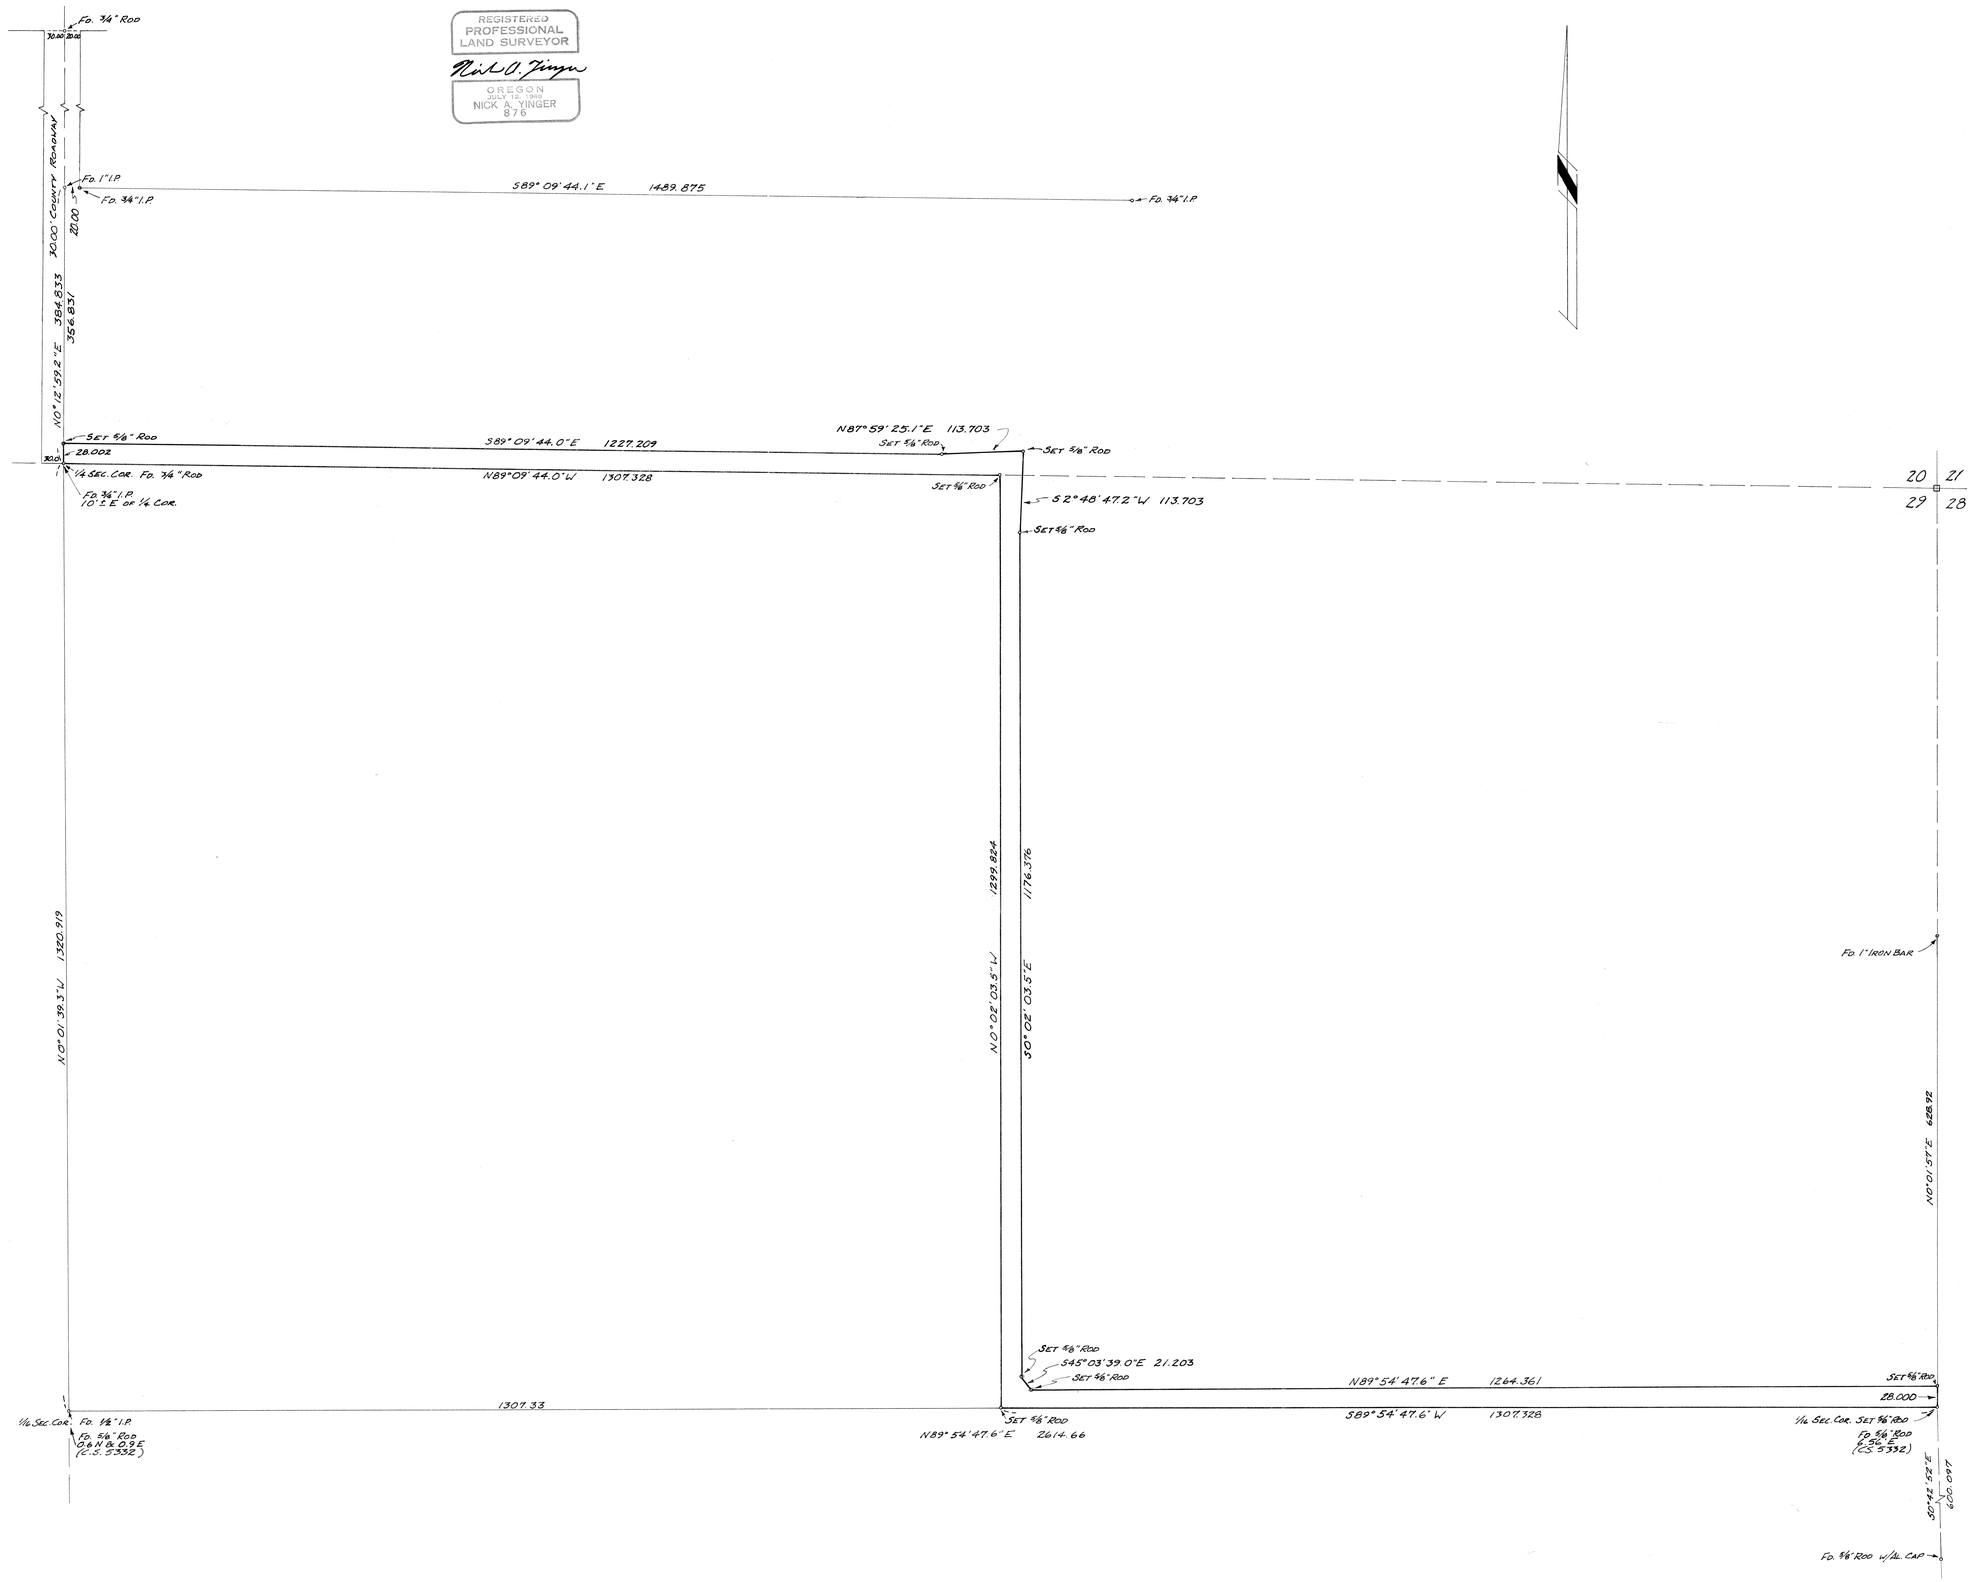
REGISTERED PROFESSIONAL LAND SURVEYOR
Nick O. Yinger
OREGON JULY 12, 1969 NICK A. YINGER 876