BOB MITCHELL

N.E. 1/4, SECTION 23, T. 10 S., R. 4 W., W.M.

Benton County, Oregon

Scale: 1" = 100'

November 9, 1976

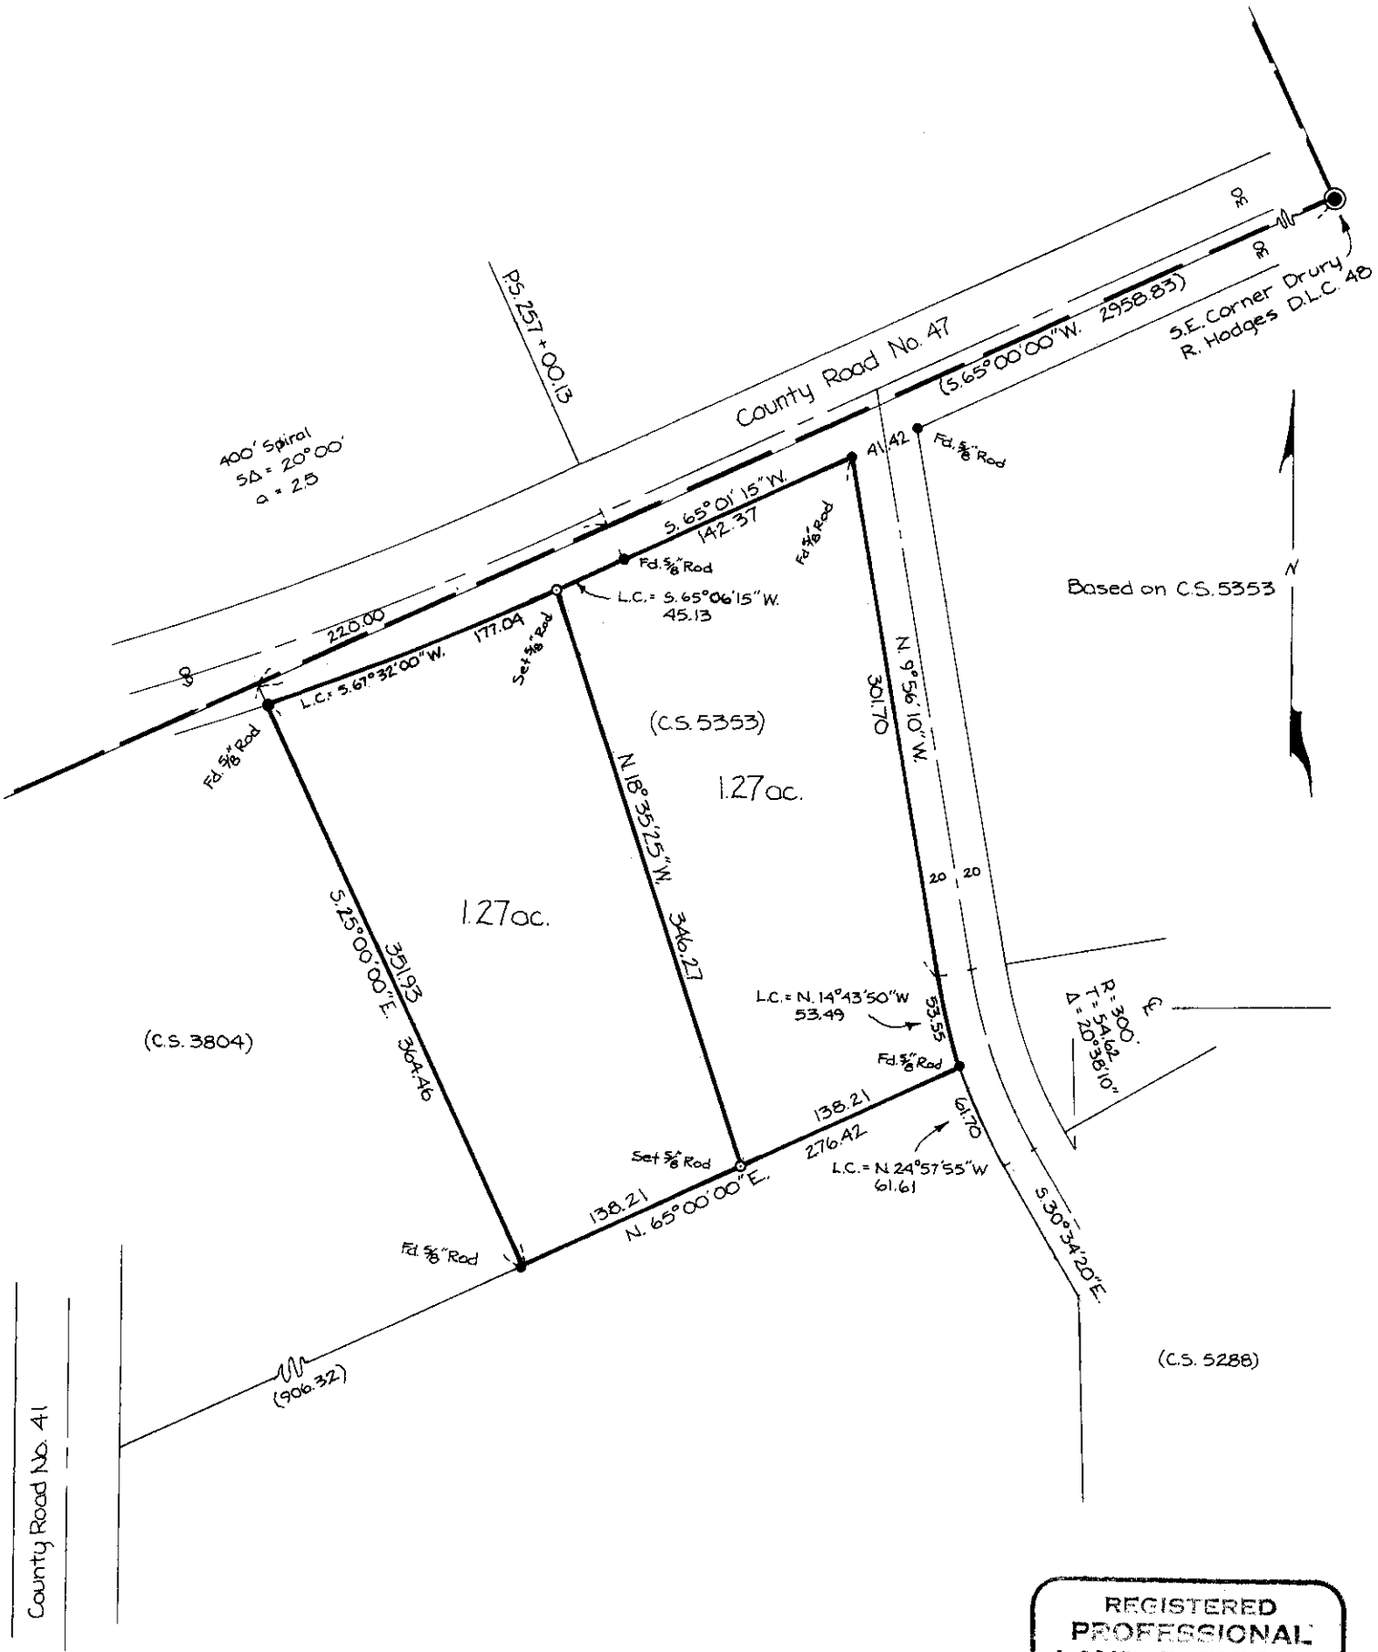

REGISTERED
PROFESSIONAL
LAND SURVEYOR

Kenneth M. Wightman

OREGON
JULY 14, 1975
KENNETH M. WIGHTMAN II
942

TIMBERLAND SERVICES, INC.
1010 Airport Road P. O. Box 668
Albany, Oregon 97321
Telephone (503) 926-9404

LAND SURVEYING - ENGINEERING
LAND USE PLANNING - ROADS
FORESTRY CONSULTING