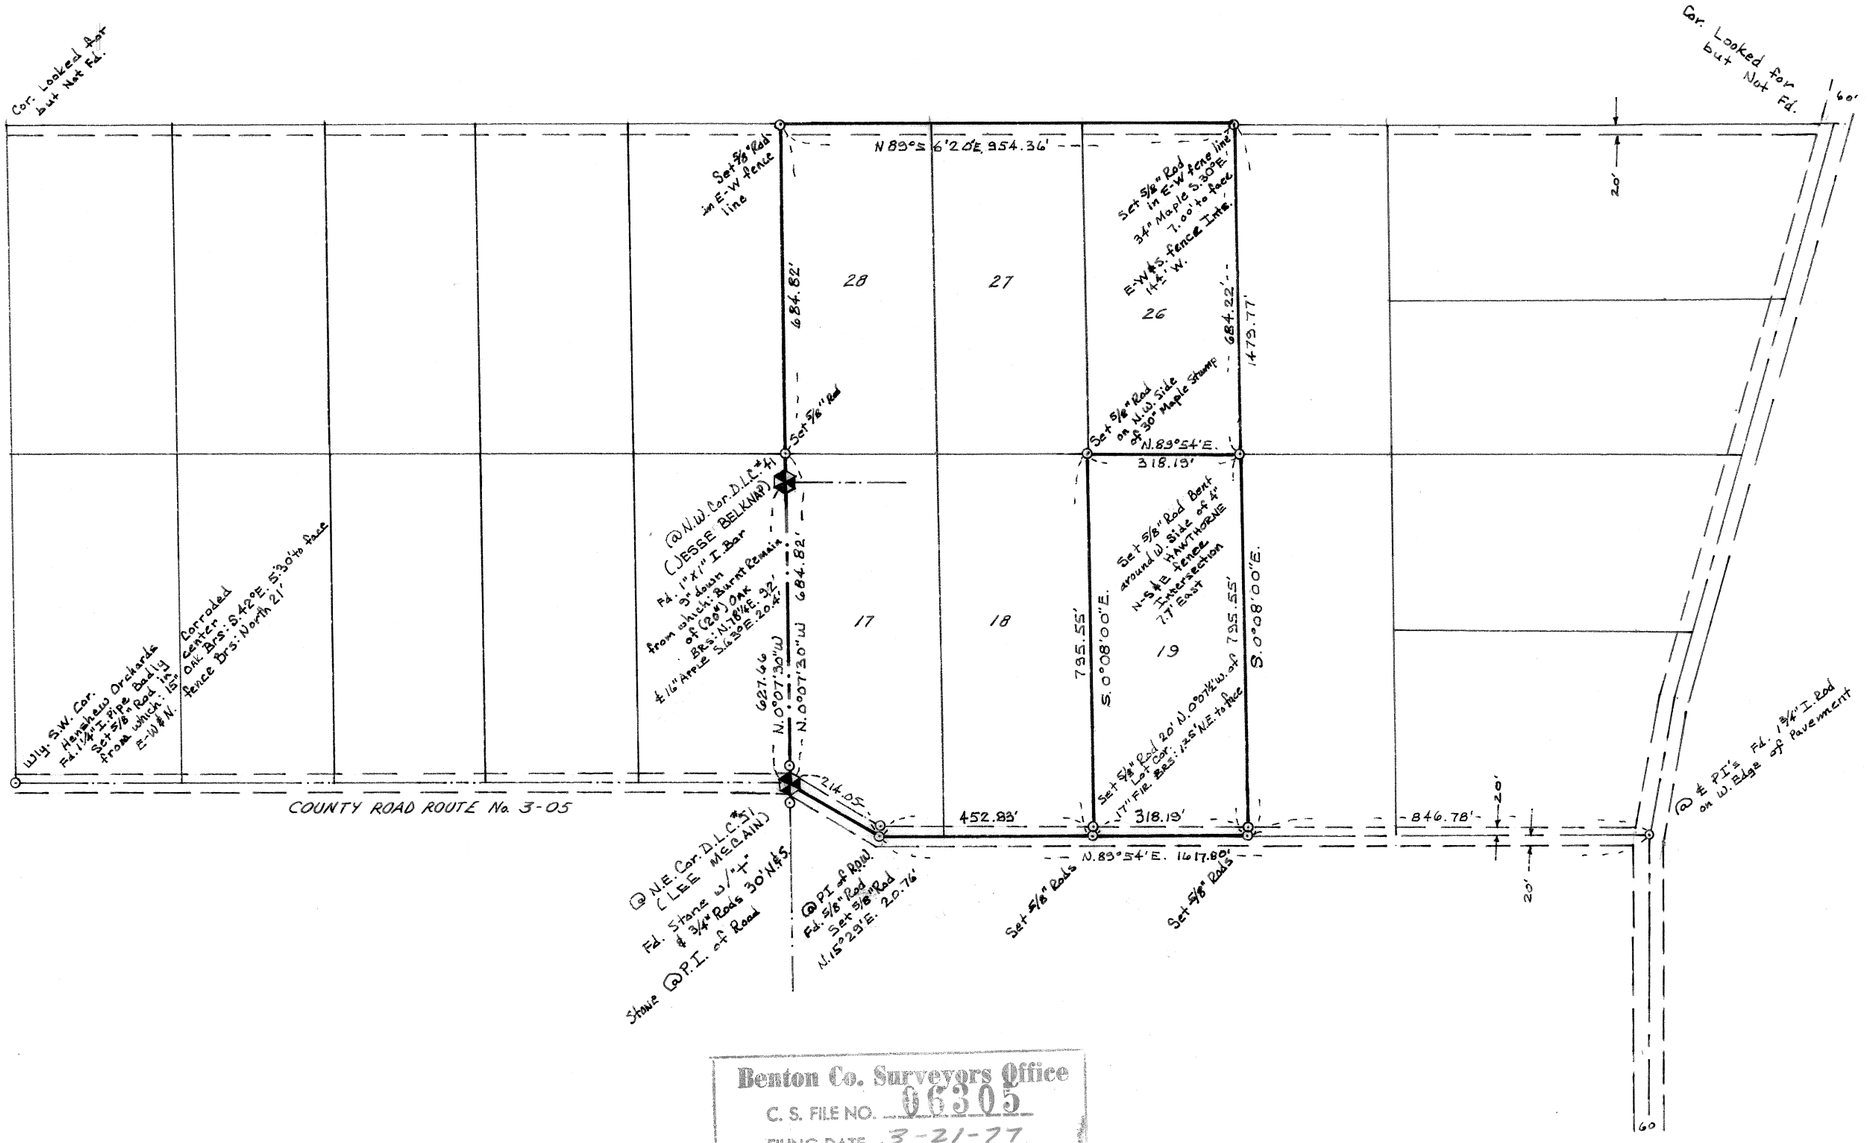

Benton Co. Surveyors Office
C. S. FILE NO. 06305
FILING DATE 3-21-77
FILE SIZE 18"

RECORD OF SURVEY FOR

KENNETH D. STEPHENS

OF LOTS 17, 18, 26, 27 & 28, HANSHEW ORCHARDS
BENTON COUNTY, OREGON
FEBRUARY 16, 1977

SCALE : 1" = 300'
● : DENOTES MONUMENT FOUND
o : DENOTES 5/8" ROD SET
( ) : DIMENSION OF RECORD
BASIS OF BEARINGS :

N

REGISTERED PROFESSIONAL LAND SURVEYOR
Fred I. Lemke
OREGON
MAY 2 1978
FRED I. LEMKE
443

06305