RECORD OF SURVEY FOR HERBERT R. SINNARD

SECTION 23 TOWNSHIP 11 SOUTH RANGE 5 WEST OF THE WILLAMETTE MERIDIAN
BEARINGS BASED ON SOLAR ESTATES SUBDIVISION RECORDED IN BOOK 8, PAGE 70, BENTON COUNTY, OREGON
SCALE 1" = 40' MARCH 15, 1978

Benton Co. Surveyors Office
C. S. FILE NO. [illegible]
FILING DATE 6-13-78
FILE SIZE 8½ x 14

REGISTERED PROFESSIONAL LAND SURVEYOR
OREGON
NEAL L. PETERSON
1496

O FOUND 5/8" ROD

● SET 5/8" ROD

( ) RECORD BEARING

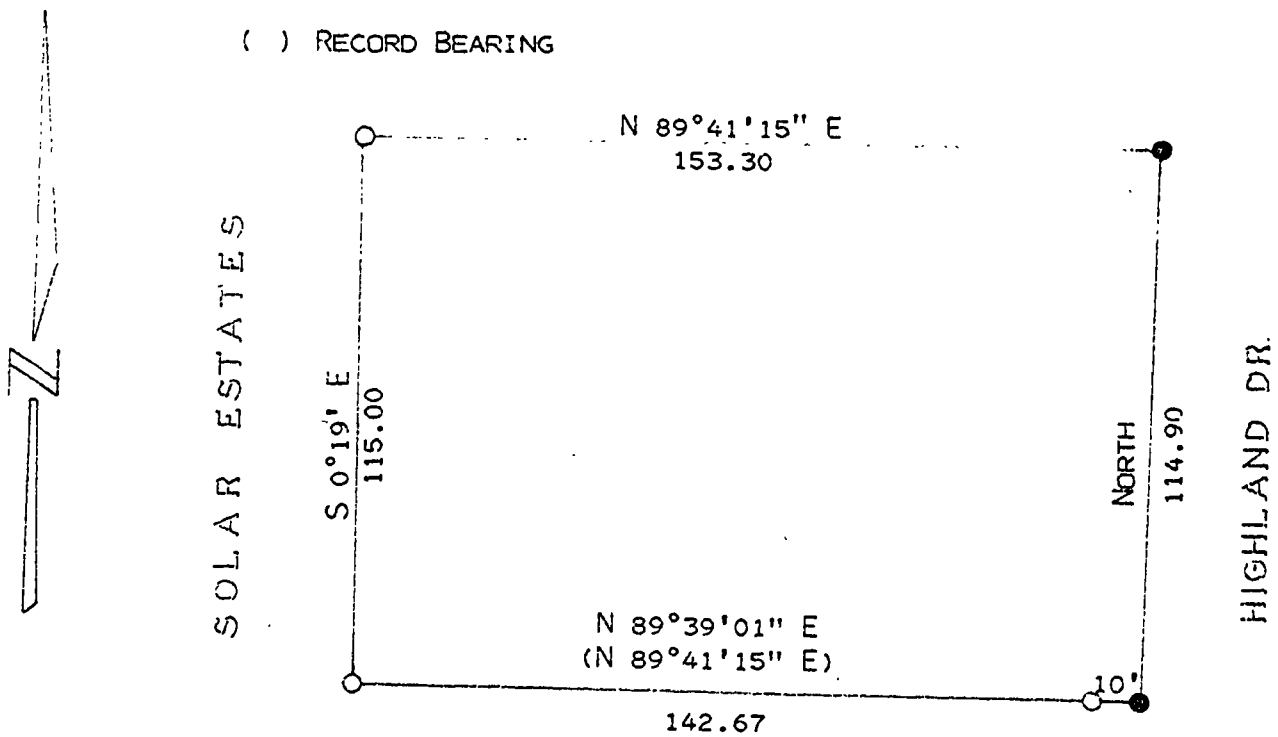

SECOND ADDITION TO CHARLEMAGNE