Benton Co. Surveyors Office
C. S. FILE NO. 06731
FILING DATE 9-15-78
FILE SIZE 8½ x 14

REGISTERED PROFESSIONAL LAND SURVEYOR
Donald Cormack
OREGON
AUGUST 22, 1975
DONALD F. CORMACK
1027

DETAIL SKETCH FOR FRANK WARLICK COMPANY SURVEY

LOCATED IN THE NW ¼ SECTION 14, T.12S., R.5W.
WILLAMETTE MERIDIAN, BENTON COUNTY, OREGON

SEPTEMBER 12, 1978

McCULLOUGH, BRYANT & ASSOCIATES
CORVALLIS, OREGON

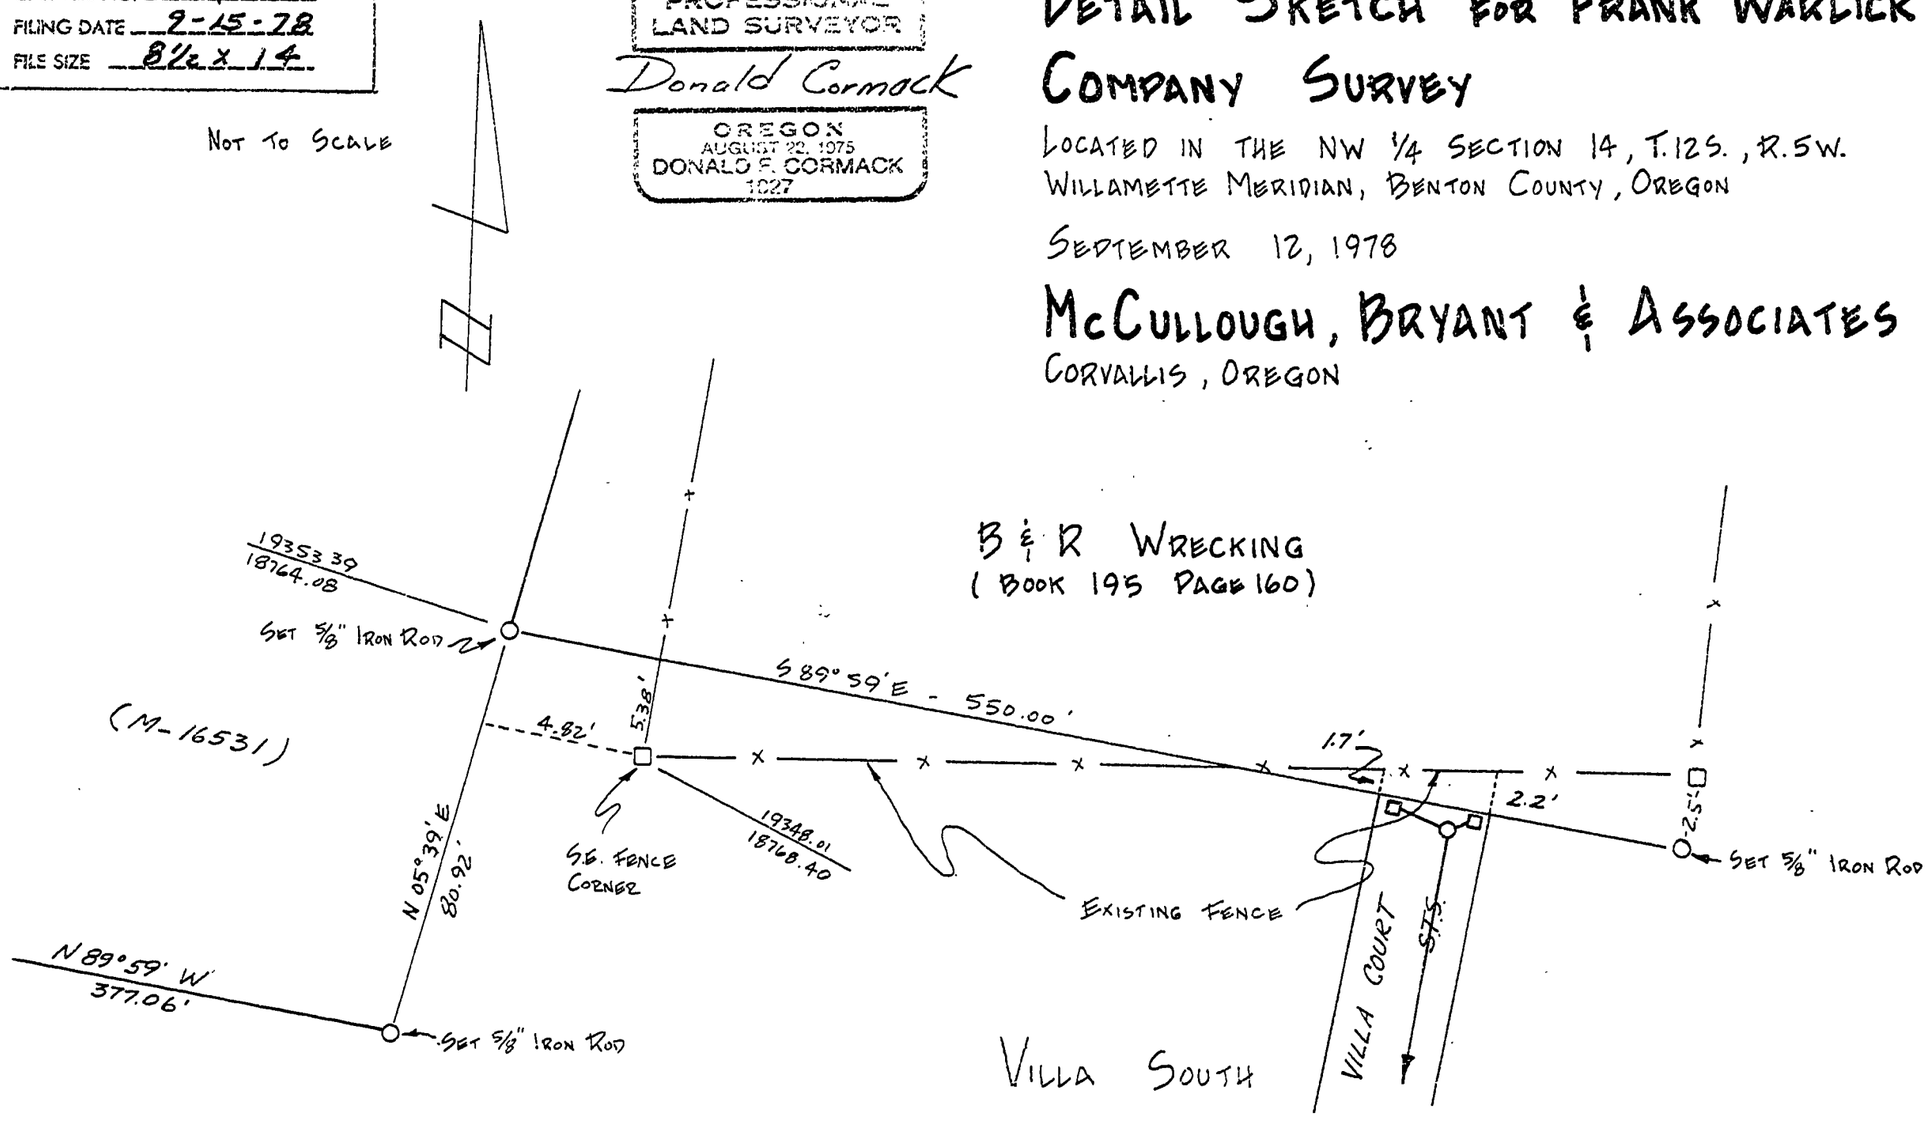

252-544