6890

NOTE: RANDOM COORDINATE TIES

LINE A = N 84°13'22 W 503.02 FT

LINE B = N 0° 30'W 55.0 FT

BENTON COUNTY SURVEYOR'S OFFICE

RECORD OF SURVEY FOR

IRISH BEND ROAD #45005

TO ACQUIRE ADDITIONAL ROAD R/W

T14S R5W WB&M

SEC 12

BENTON COUNTY, OREGON

MAY 1979

BASED ON SURVEY 161 & 5360, 6138

SCALE 1"=200'

Benton Co. Surveyors Office
C.S. FILE NO. 6890
FILING DATE 5-15-79
SURVEY SIZE 15 X 24
di

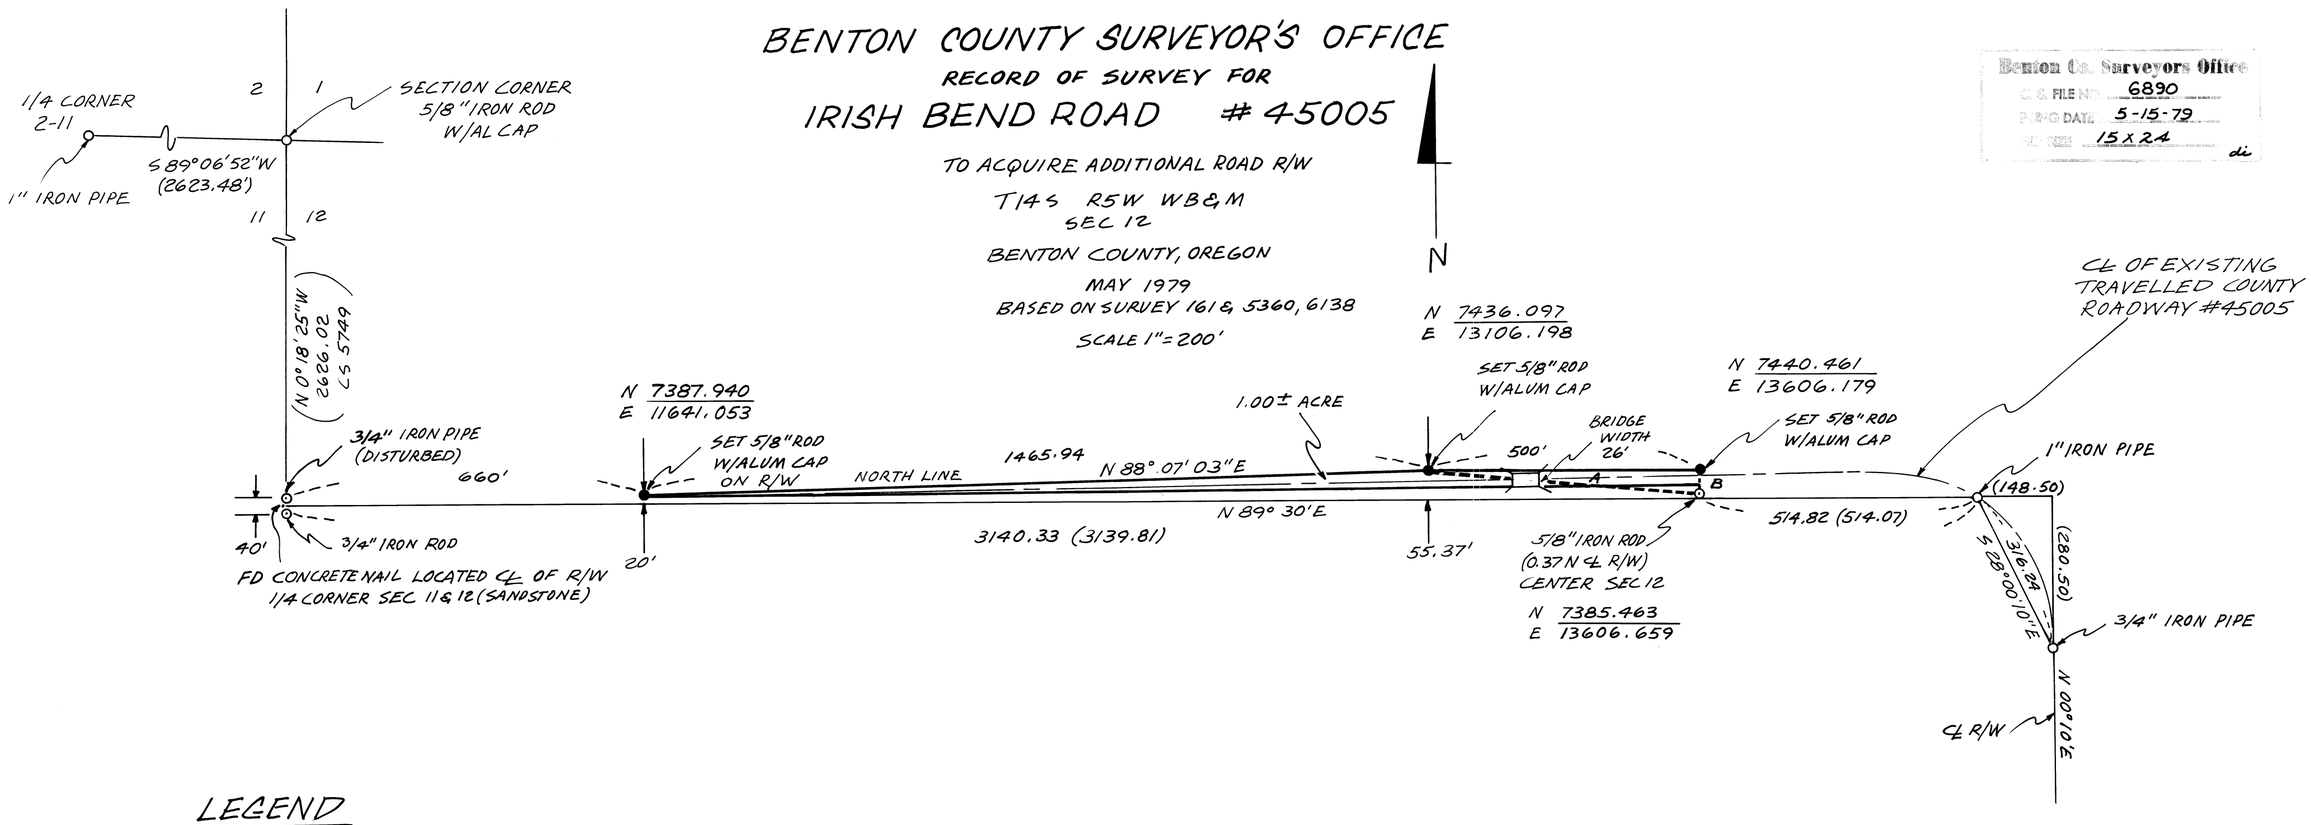

LEGEND

- ● SET 5/8" ROD W/ALUM CAP BENTON COUNTY
- o FOUND MONUMENTATION AS DESCRIBED
- ( ) RECORD BEARINGS AND DISTANCES

REGISTERED PROFESSIONAL LAND SURVEYOR

James E. Blair

OREGON JULY 10, 1979 JAMES F. BLAIR 907

BENTON COUNTY SURVEYOR

ERROR OF CLOSURE 1/52750

6889