Survey For Charles Cox
in the S.E. 1/4 of Section 3, T. 12 SR 6 W. of the W.M.
and the Robert Garrett D.L.C. #71
Benton County Oregon
scale 1" = 100' Survey Ap. 18 1981

Narrative
survey based on iron rod's
set in previous survey # 7146
and adding 120' x 105.5 ft Tract;
all within the SE 1/4 of Section 3

T. 12 SR 6 W. W.M. B.C. Ore.

J.W. Hanna
210 S.W. 2nd St.
Newport Ore.

REGISTERED PROFESSIONAL LAND SURVEYOR
J. W. Hanna
OREGON
NOV. 6, 1953
J. W. HANNA
306
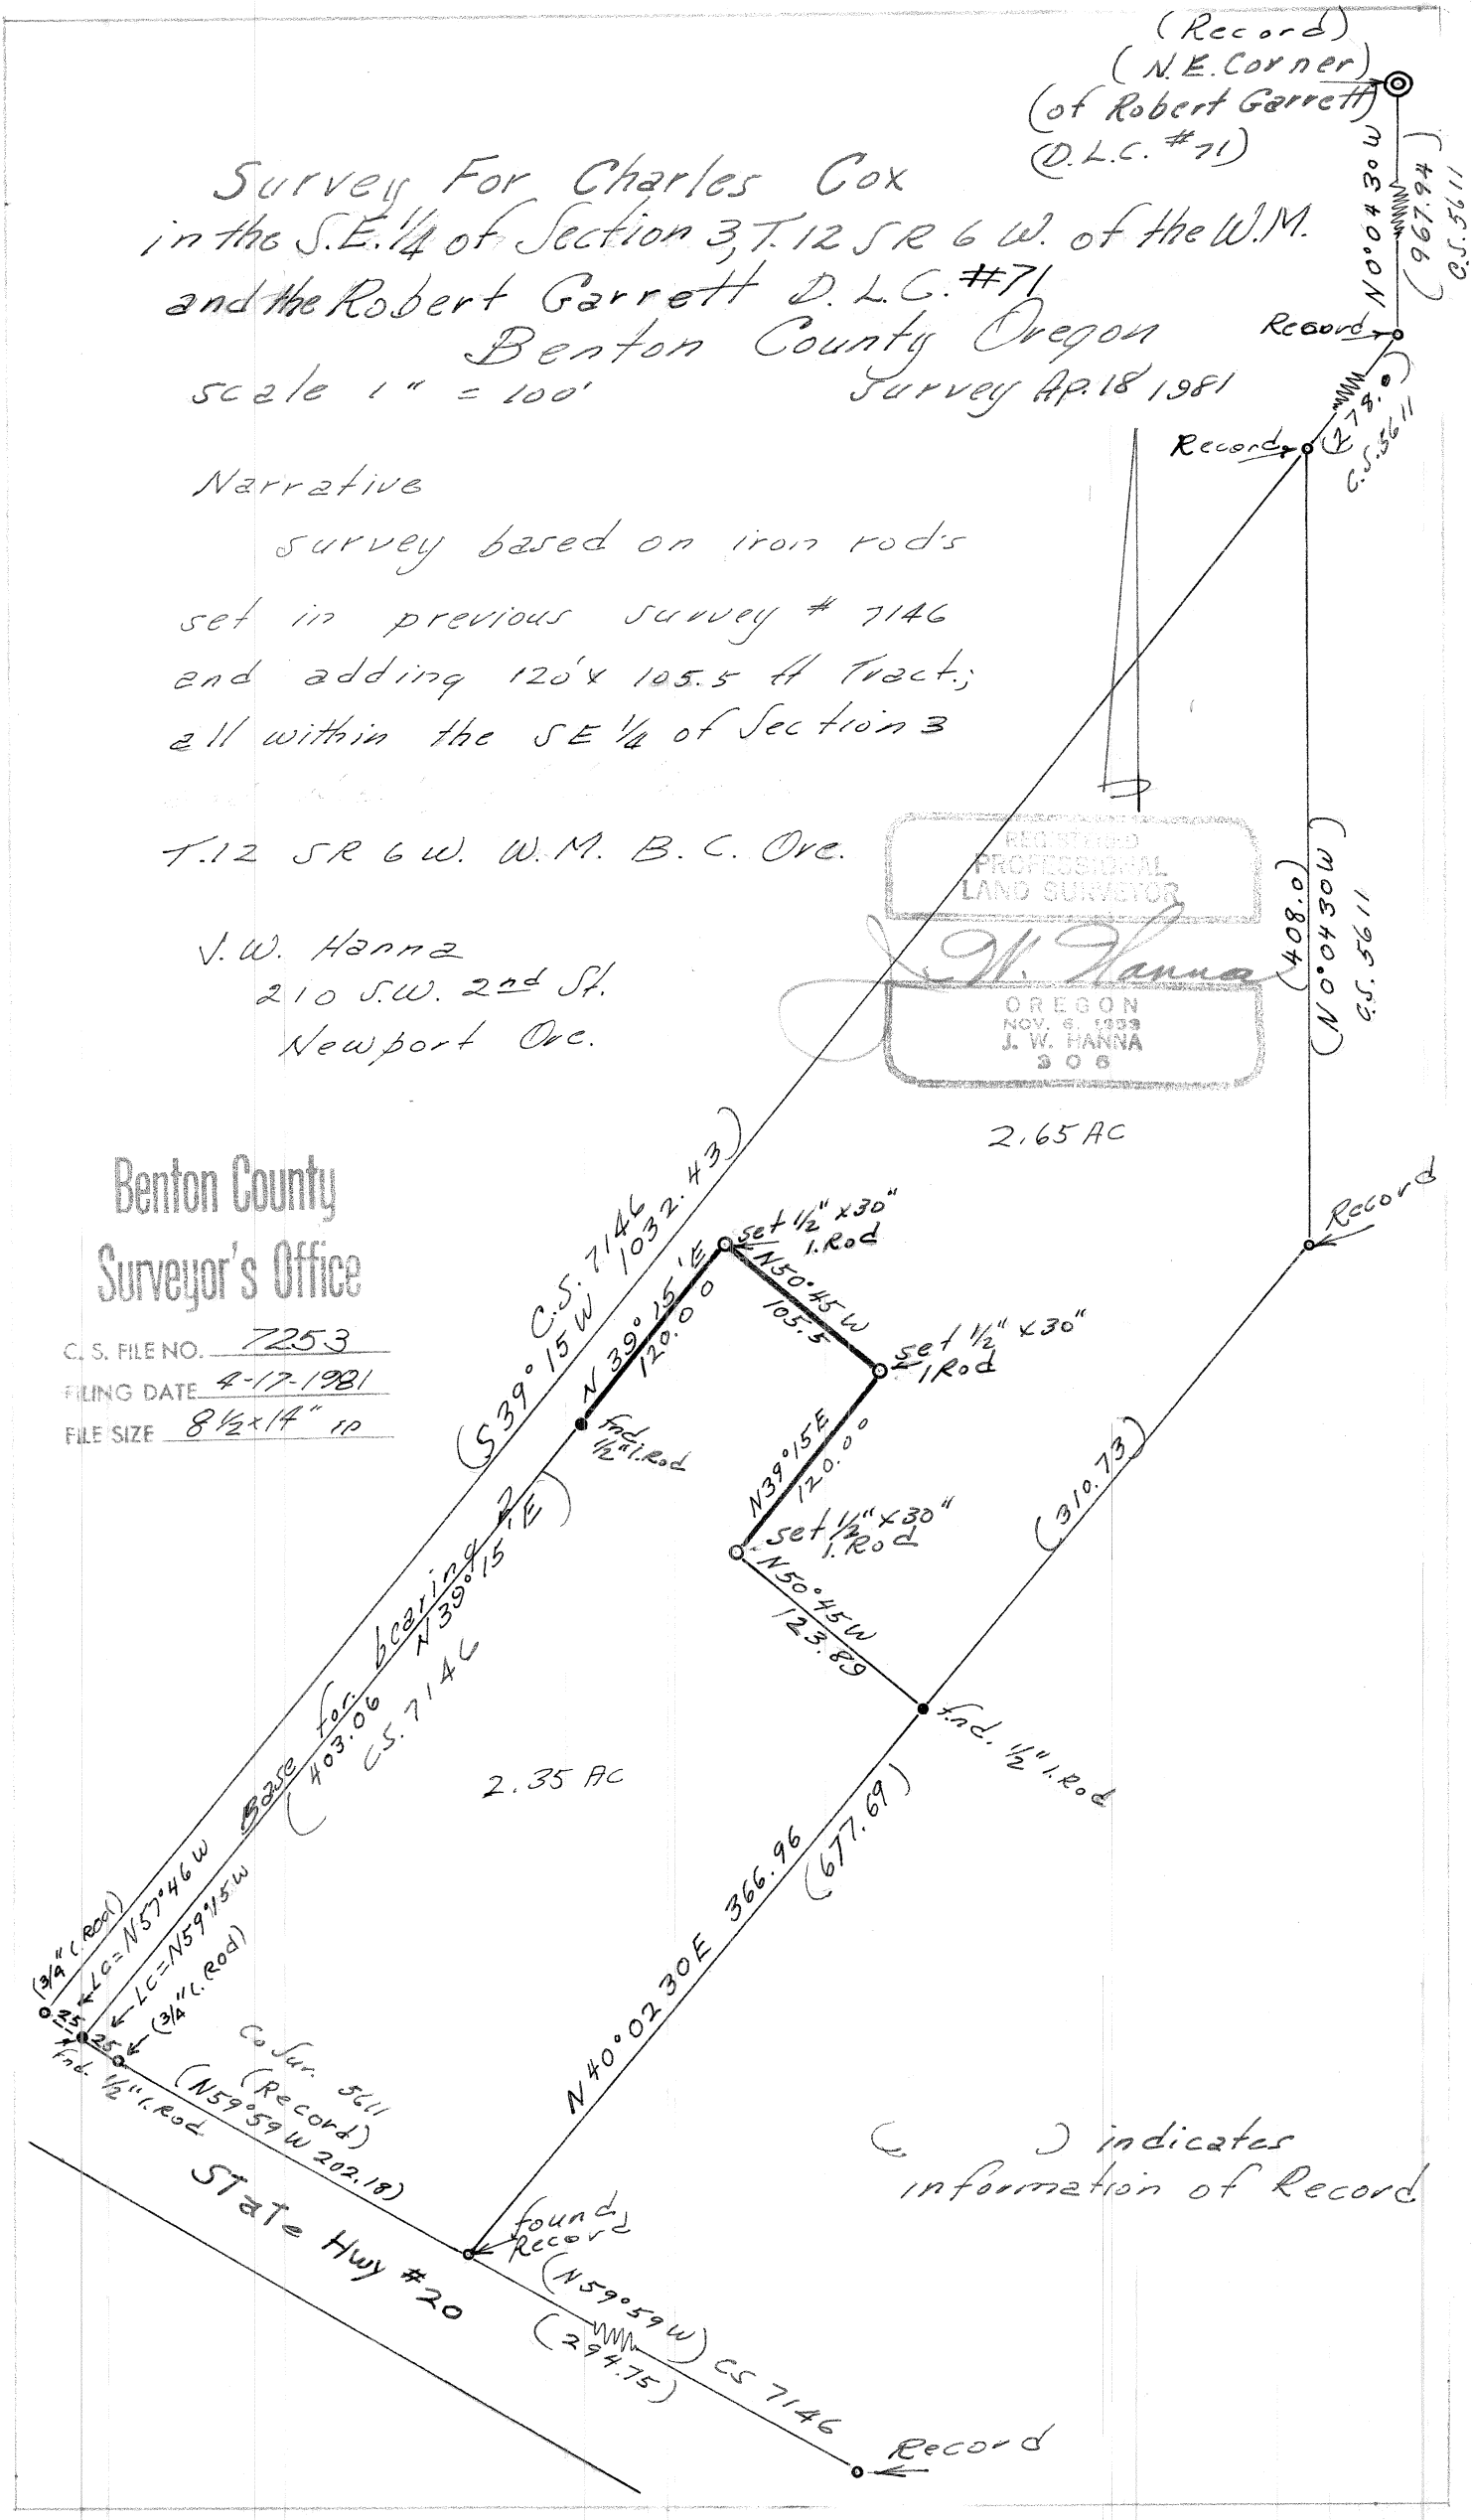
Benton County
Surveyor's Office
C. S. FILE NO. 7253
FILING DATE 4-17-1981
FILE SIZE 8 1/2 x 14" rp