8537
8-13-91

Benton County
Surveyor's Office
C.S. I.D. NO. 8537
FILING DATE 8-13-1991
FILE SIZE 11x17

RECORD OF SURVEY FOR TIM CLEVELAND

IN THE S.W.1/4 OF SEC.14, T.11S., R.7W., W.M.
BENTON COUNTY, OREGON AUGUST 8, 1991

WESTERN SURVEYING 1334 MAIN STREET, PHILOMATH OREGON PHONE (503)929-3355

NARRATIVE: THE PURPOSE OF THIS SURVEY IS TO LOCATE AND MONUMENT THE DIVISION LINE BETWEEN TAX LOTS 1104 AND 1101. COUNTY SURVEY NUMBER 6409 WAS USED AS CONTROL IN LOCATING THE EXTERIOR BOUNDARIES OF TAX LOTS 1104 AND 1101, DEED CALLS FROM MICROFILM NUMBER 118712, BENTON COUNTY RECORDS, WAS USED TO LOCATE THE DIVISION LINE. A THEODOLITE AND E.D.M. WAS USED ON A CLOSED RANDOM TRAVERSE TO DO THIS SURVEY.

- O SET 5/8"X 30" REBAR WITH A YELLOW PLASTIC CAP MARKED 'WEST. SURV. L.S.1901'
- ( ) INFORMATION OF RECORD
- ● FOUND MONUMENTS OF RECORD FROM CS 6409 (5/8" REBARS) UNLESS NOTED OTHERWISE
- A INFORMATION FROM MICROFILM NO, 118712 BENTON COUNTY RECORDS
- B INFORMATION FROM CS 6409
- C INFORMATION FROM CS 7532

REGISTERED PROFESSIONAL LAND SURVEYOR
John D. Howell
OREGON
JULY 18 1980
JOHN D. HOWELL
1901

BENTON COUNTY SURVEYOR
DLC45
DLC45
SW J. VANDERPOOL
T11S R7W
1988
DO NOT DISTURB

FOUND 3 1/4" BRASS CAP
AS PER C.R.3501

SCALE 1"=200'

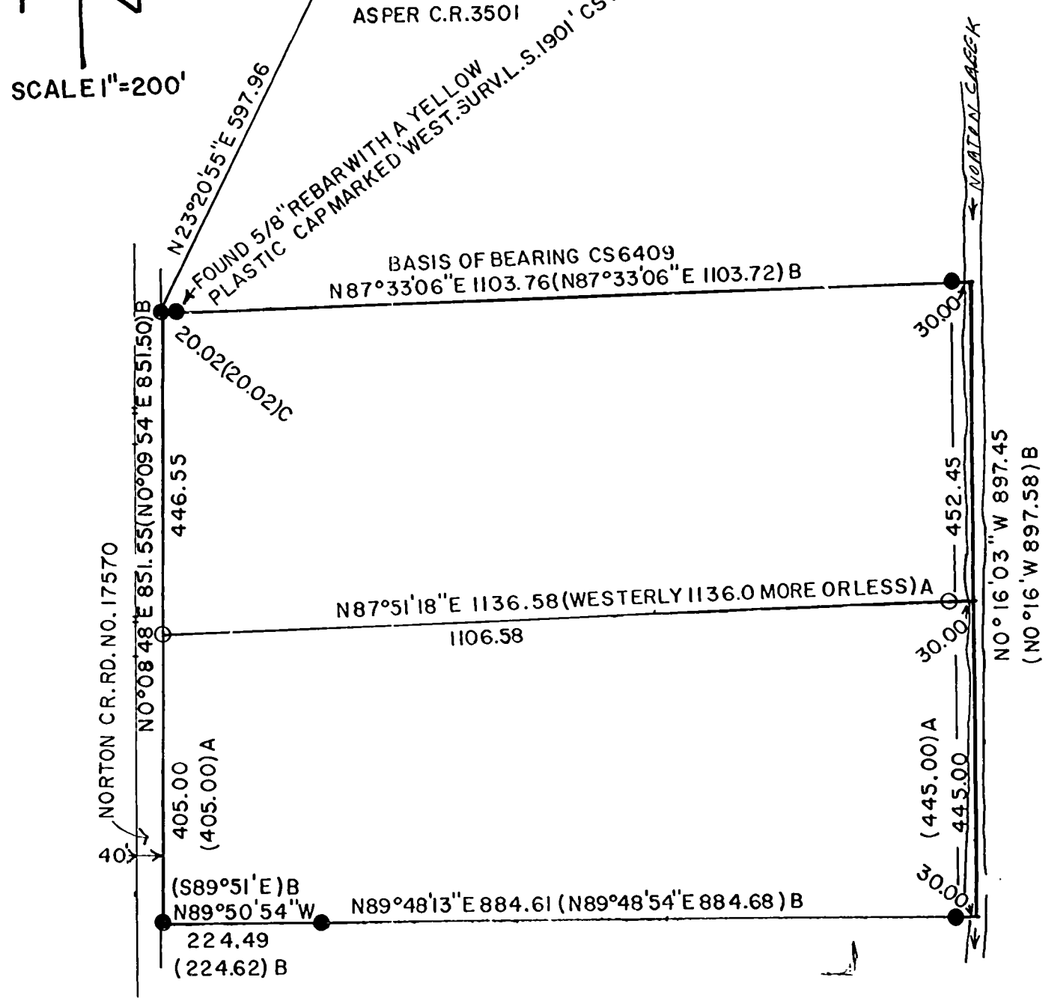

DRAWING NUMBER 8537
PLAN HOLD CORPORATION • IRVINE, CALIFORNIA
REORDER BY NUMBER 075AR
POSITION EDGE OF PRINT ON THIS LINE

DRAWING NUMBER 8537
PLAN HOLD CORPORATION • IRVINE, CALIFORNIA
REORDER BY NUMBER 075AR
POSITION EDGE OF PRINT ON THIS LINE